




LOCATION MAP

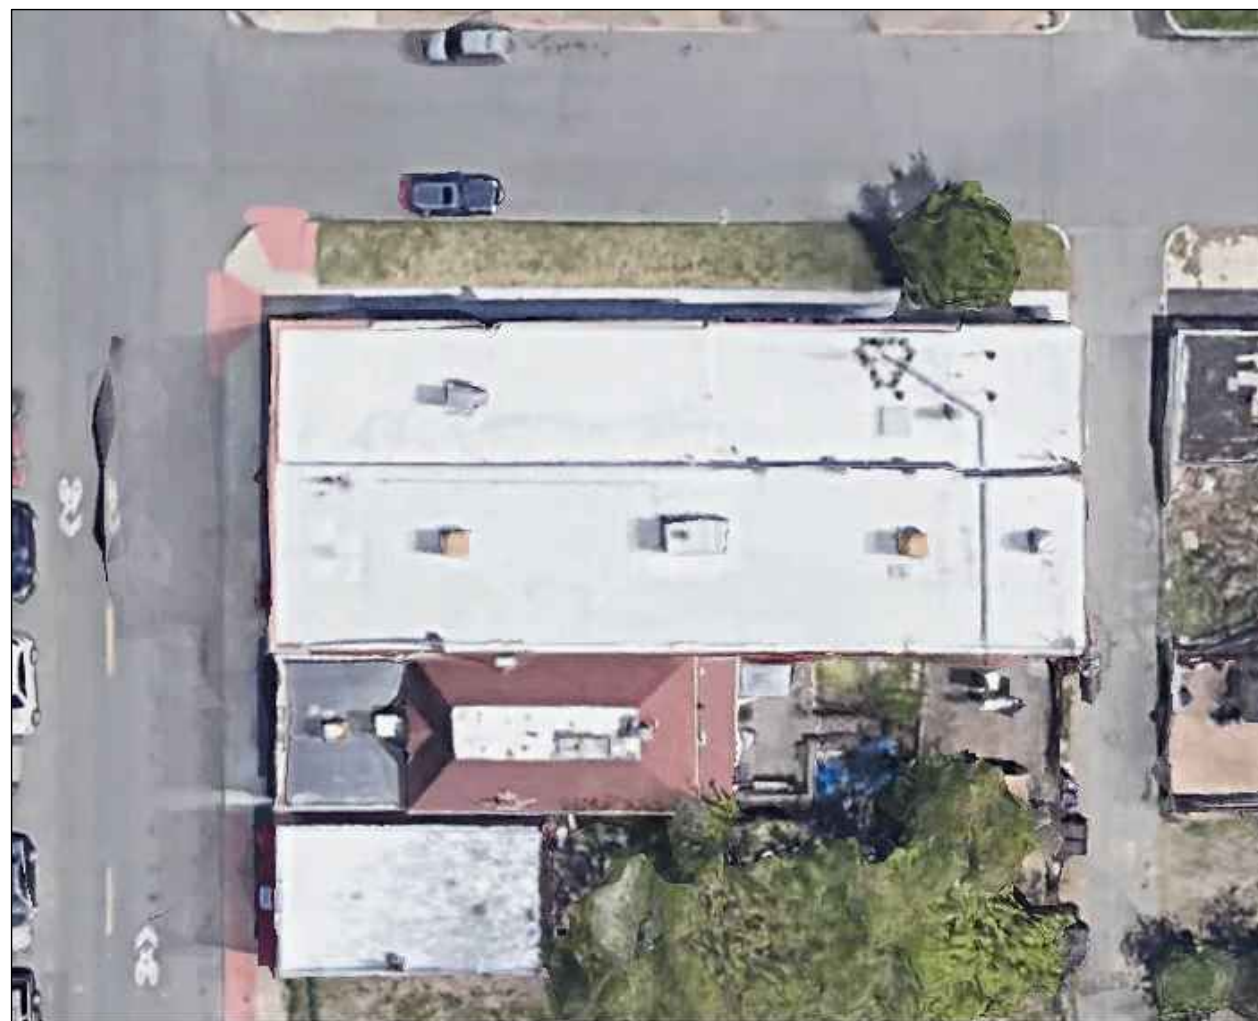

STREET VIEW

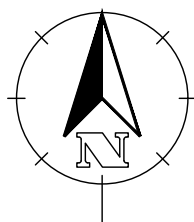

AERIAL MAP

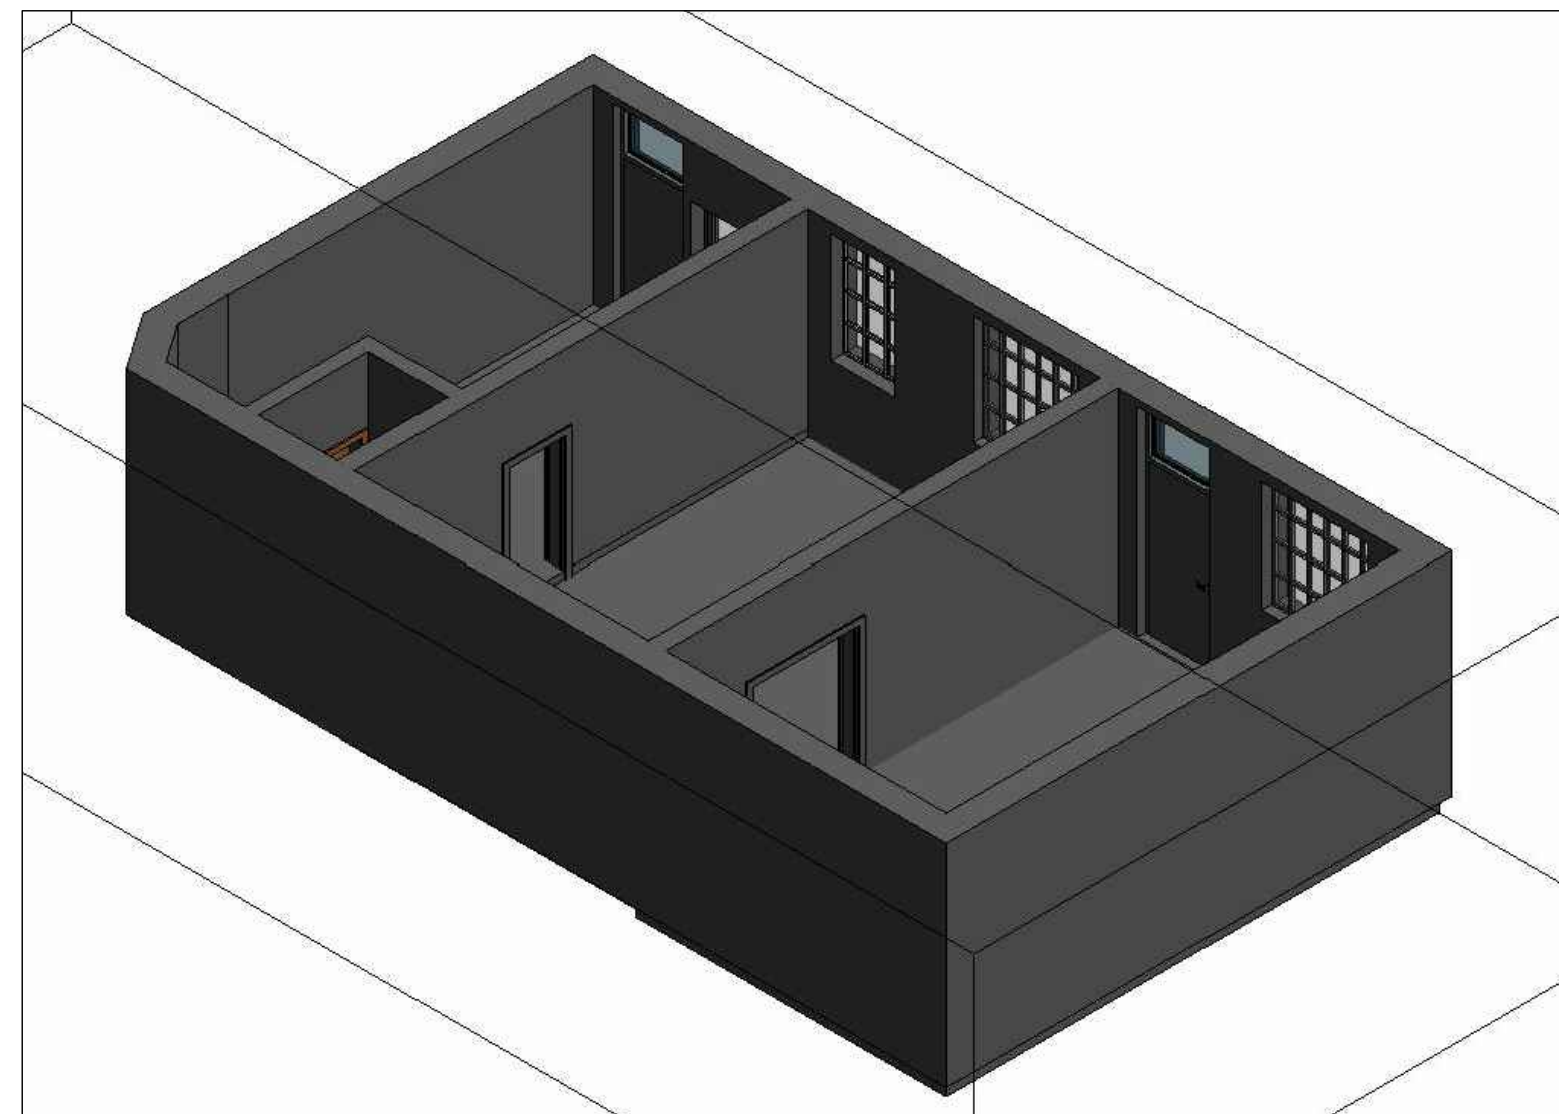

3D MODEL OVERVIEW

Notes:

1. ALL PLANS ARE CREATED BY REALTY 360° VIEW AND MADE EXCLUSIVELY FOR REAL ESTATE MARKETING PURPOSES.

0	ISSUED FOR INFORMATION	RGE	9/12/20
REV:	DESCRIPTION:	BY:	DATE:

STATUS: AS-BUILT

REALTOR/BROKERAGE:

JAY MODGLIN
 Mobile: (303) 472-2150
 Office: (303) 820-2489
 Email: jay@kentwood.com
 Web: <http://www.jaymodglin.com/>



PRESENTED BY:


REALTY 360° VIEW
 Call or Text Us at: 720-770-1230
 Email Direct at: CR@Realty360View.com
 Website: <https://realty360view.com/>
 Address: 242 Linden St Fort Collins, CO 80524



SITE/: 1430 W 37th Ave Denver, Co 80211, USA


TITLE: AS-BUILT DRAWING

SCALE: NTS	DATE: 09/12/20	DRAWN: RGE	APPROVED:
PROJECT NO: Prop.Tours/y36	SHEET NO: 1/7	REVISION: 0	

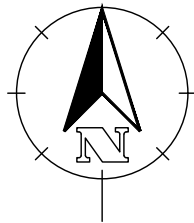

Notes:

1. ALL PLANS ARE CREATED BY REALTY 360° VIEW AND MADE EXCLUSIVELY FOR REAL ESTATE MARKETING PURPOSES.

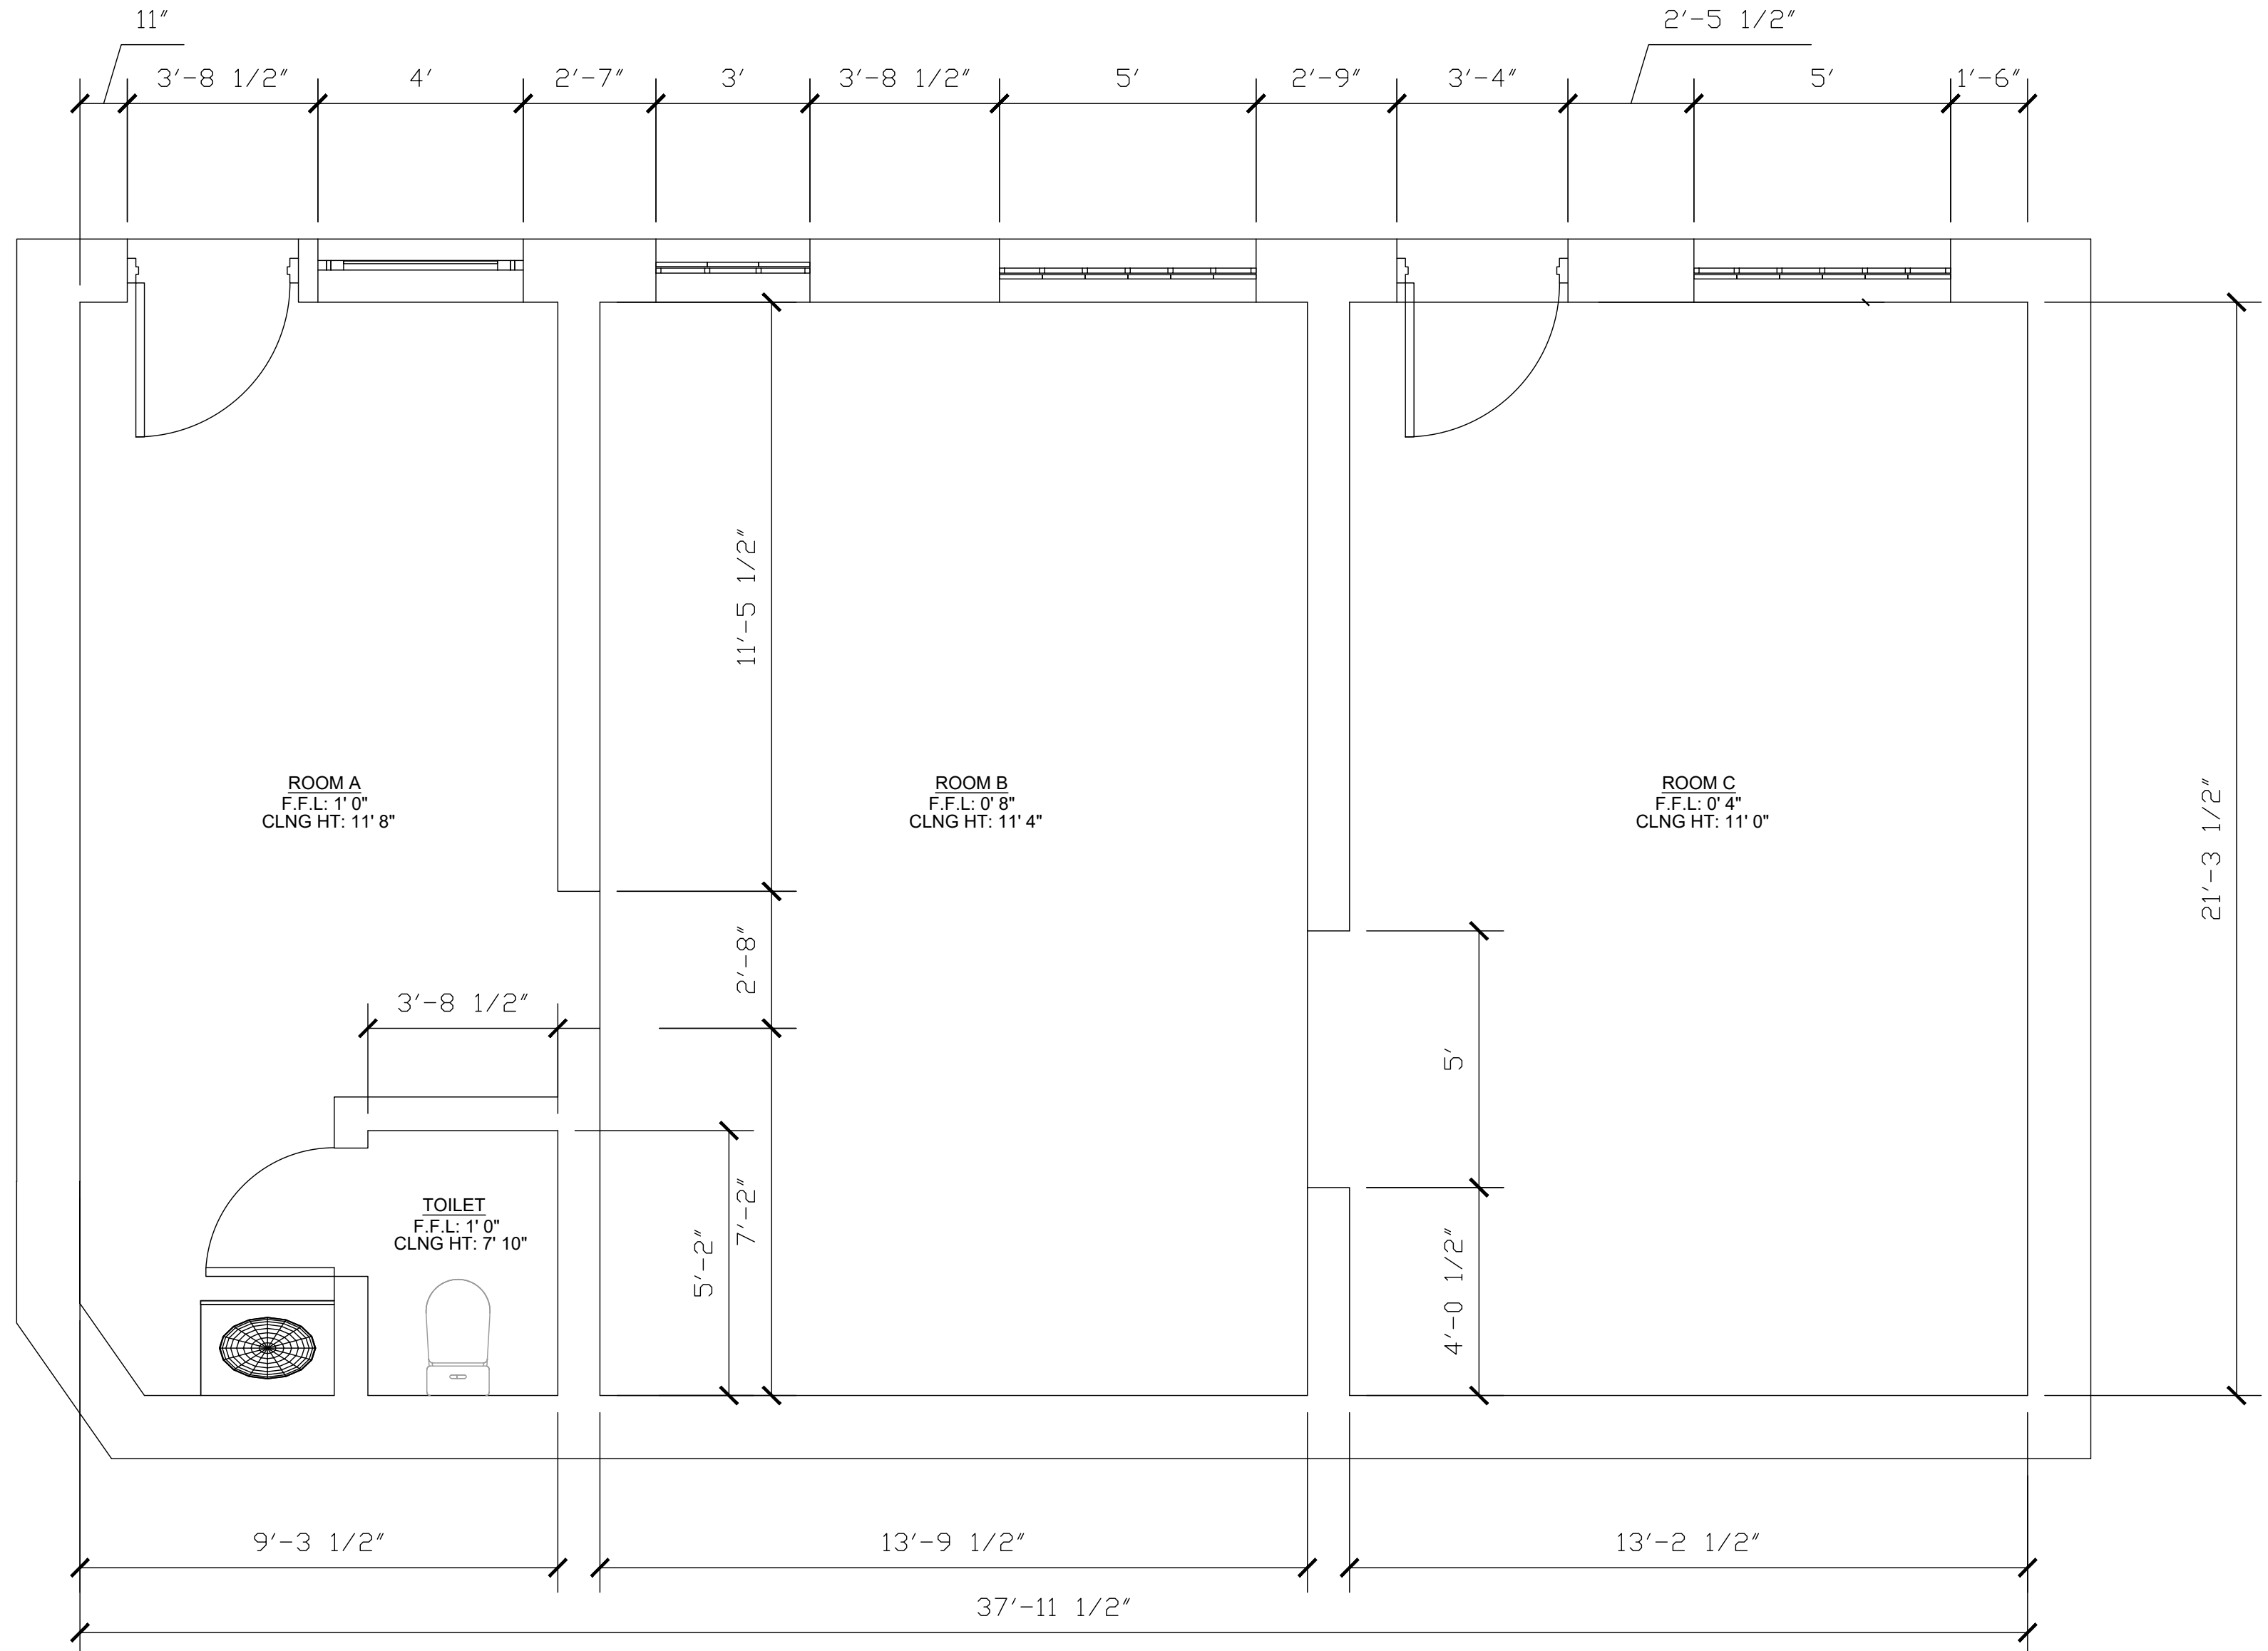

2 FLOOR PLAN
SCALE: 3/8" = 1'-0"

ABBREVIATIONS

T.O.P	TOP OF PARAPET
B.O.J	BOTTOM OF JOIST
B.O.D	BOTTOM OF DUCT
B.O.D	BOTTOM OF DUCT
F.F.L	FINISH FLOOR LINE
N.G.L	NATURAL GRADE LINE
CLNG HT	CEILING HEIGHT

0	ISSUED FOR INFORMATION	RGE	9/12/20
REV:	DESCRIPTION:	BY:	DATE:

STATUS: **AS-BUILT**

REALTOR/BROKERAGE:

JAY MODGLIN
 Mobile: (303) 472-2150
 Office: (303) 820-2489
 Email: jay@kentwood.com
 Web: <http://www.jaymodglin.com/>



PRESENTED BY:


REALTY 360° VIEW
 Call or Text Us at: 720-770-1230
 Email Direct at: CR@Realty360View.com
 Website: <https://realty360view.com/>
 Address: 242 Linden St Fort Collins, CO 80524



SITE/:
1430 W 37th Ave Denver, Co 80211, USA


TITLE:
AS-BUILT DRAWING

SCALE: 3/8" = 1'-0"	DATE: 09/12/20	DRAWN: RGE	APPROVED:
PROJECT NO: Prop.Tours/y36	SHEET NO: 2/7	REVISION: 0	

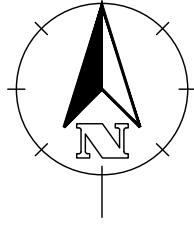

Notes:

1. ALL PLANS ARE CREATED BY REALTY 360° VIEW AND MADE EXCLUSIVELY FOR REAL ESTATE MARKETING PURPOSES.

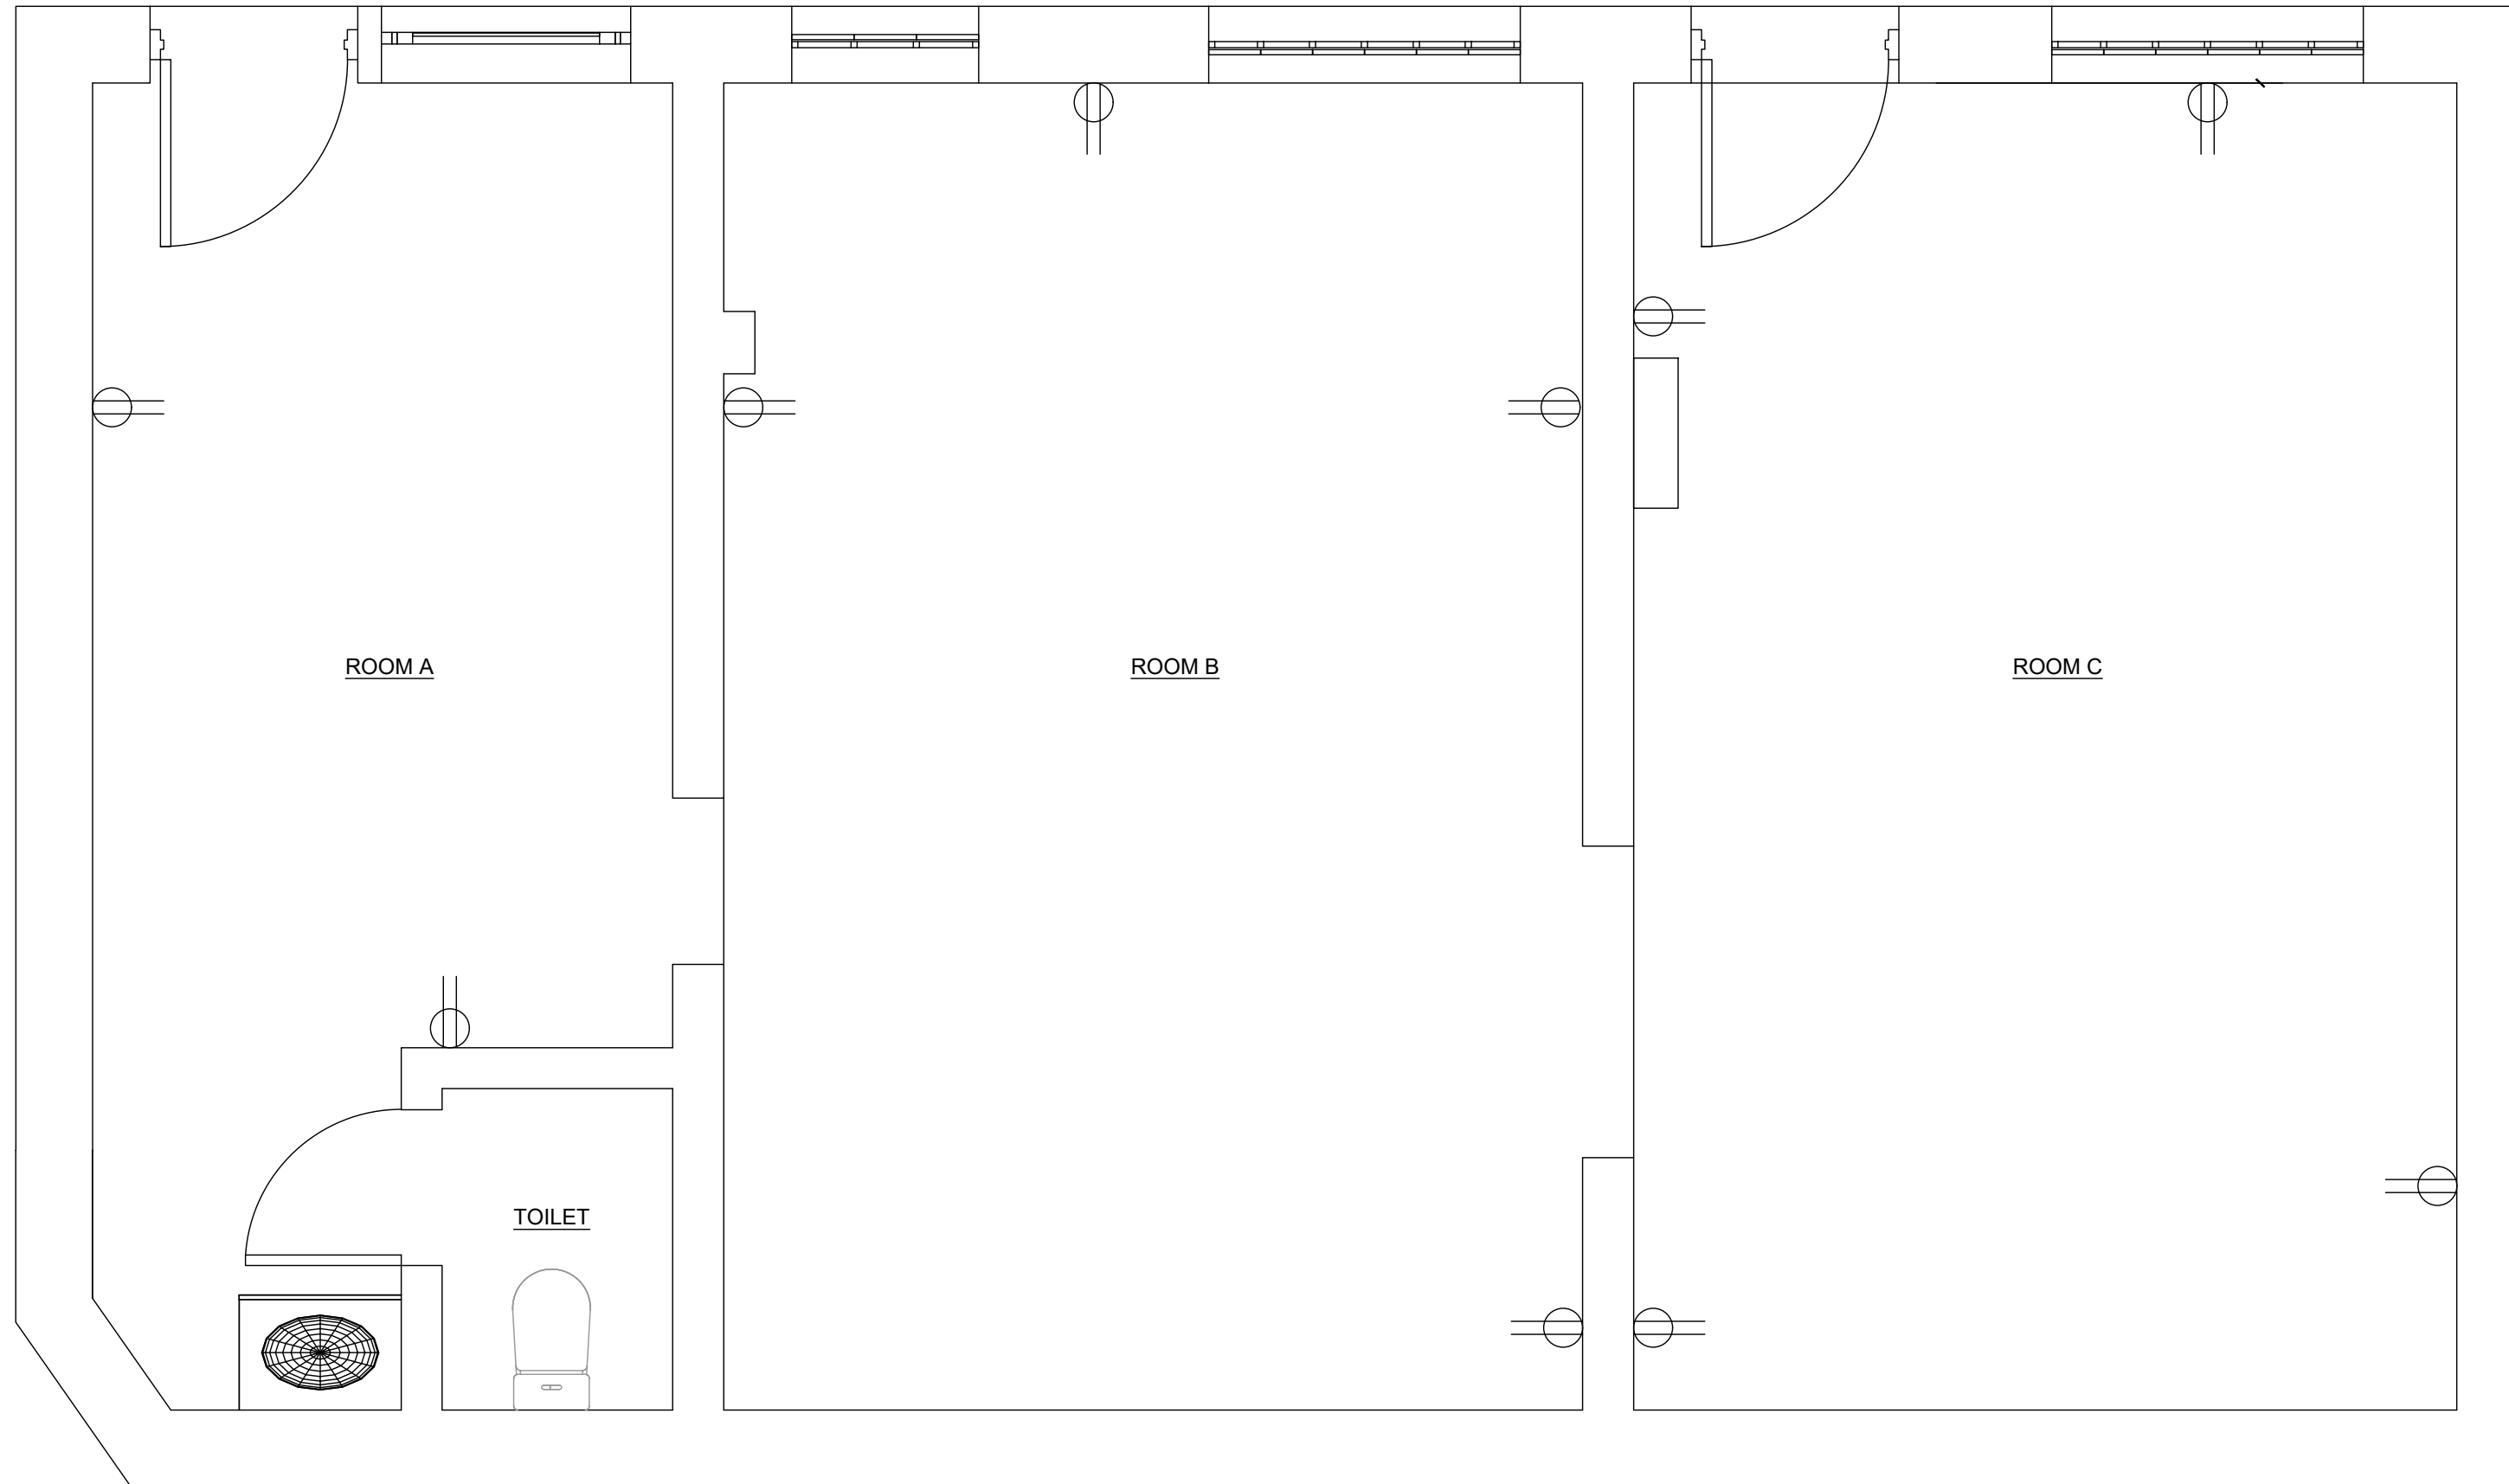

MEP LEGEND

	DUPLEX ELECTRICAL OUTLET
	DRAIN
	DATA PORT
	EMERGENCY LIGHT
	FIRE EXTINGUISHER
	MOTION SENSOR
	ELECTRICAL PANEL

0	ISSUED FOR INFORMATION	RGE	9/12/20
REV:	DESCRIPTION:	BY:	DATE:

STATUS: **AS-BUILT**

REALTOR/BROKERAGE:

JAY MODGLIN
 Mobile: (303) 472-2150
 Office: (303) 820-2489
 Email: jay@kentwood.com
 Web: <http://www.jaymodglin.com/>



PRESENTED BY:

REALTY 360° VIEW
 Call or Text Us at: 720-770-1230
 Email Direct at: CR@Realty360View.com
 Website: <https://realty360view.com/>
 Address: 242 Linden St Fort Collins, CO 80524




SITE/: 1430 W 37th Ave Denver, Co 80211, USA

TITLE: **AS-BUILT DRAWING**

SCALE: NTS	DATE: 09/12/20	DRAWN: RGE	APPROVED:
PROJECT NO: Prop.Tours/y36	SHEET NO: 3/7	REVISION: 0	


2 MEP PLAN
 SCALE: 3/8" = 1'-0"

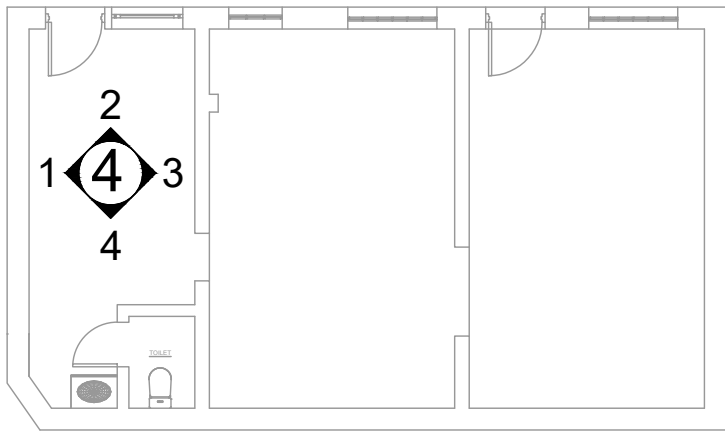

KEYPLAN




4.1 INTERIOR ELEVATION
SCALE: 3/8"=1'-0"

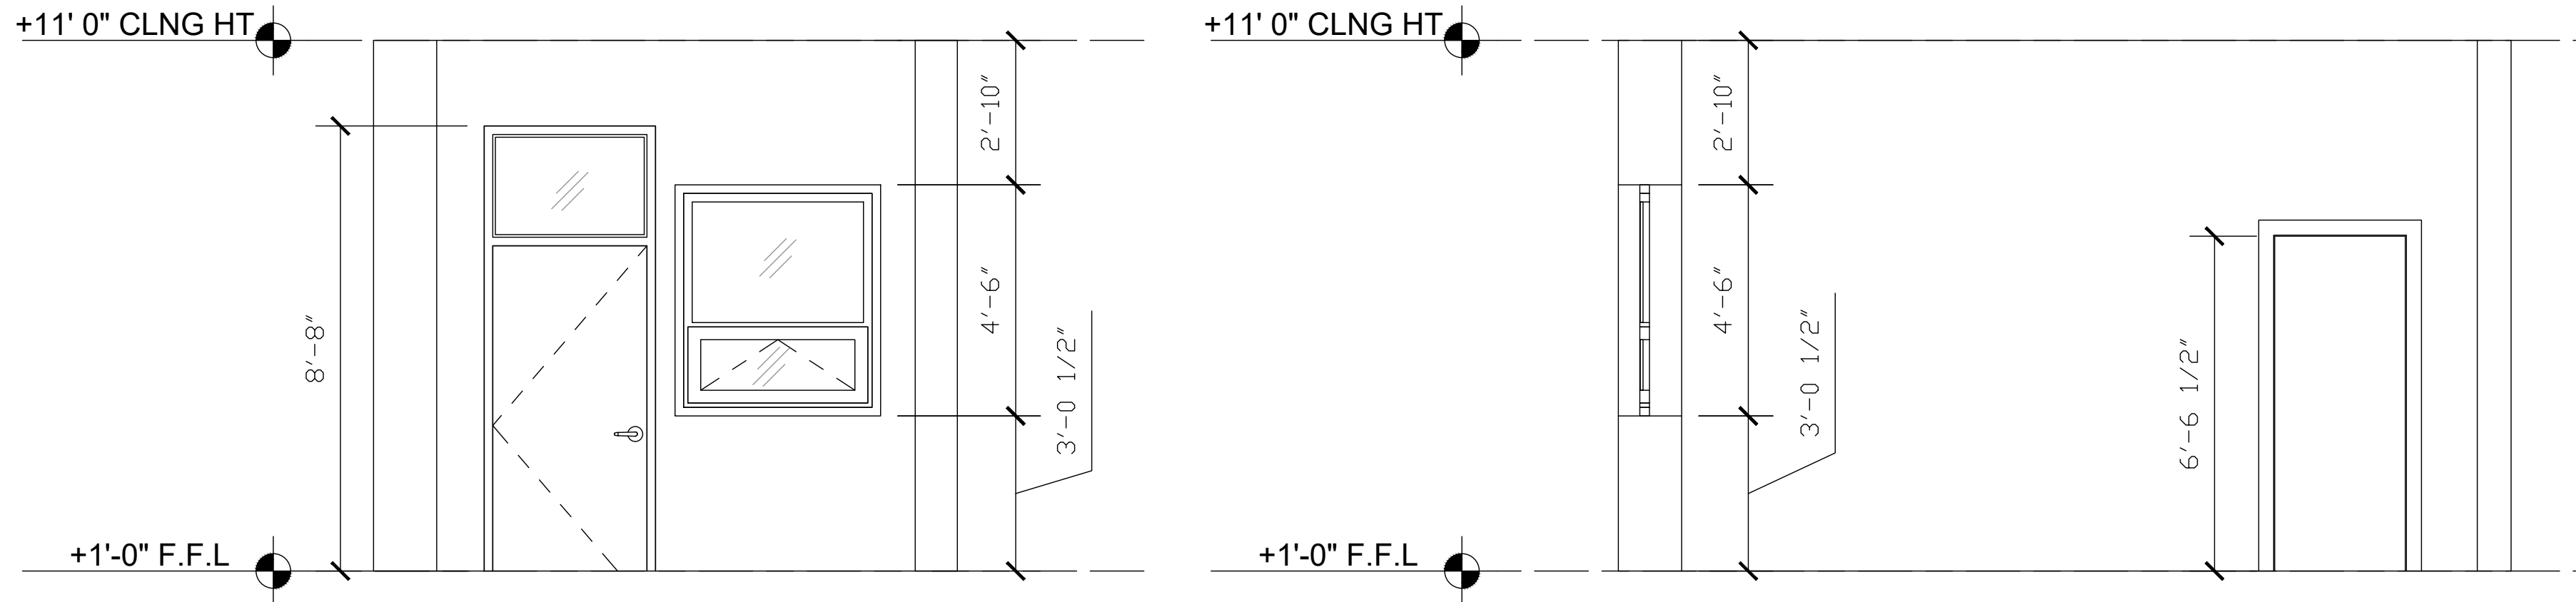

4.2 INTERIOR ELEVATION
SCALE: 3/8"=1'-0"

4.3 INTERIOR ELEVATION
SCALE: 3/8"=1'-0"

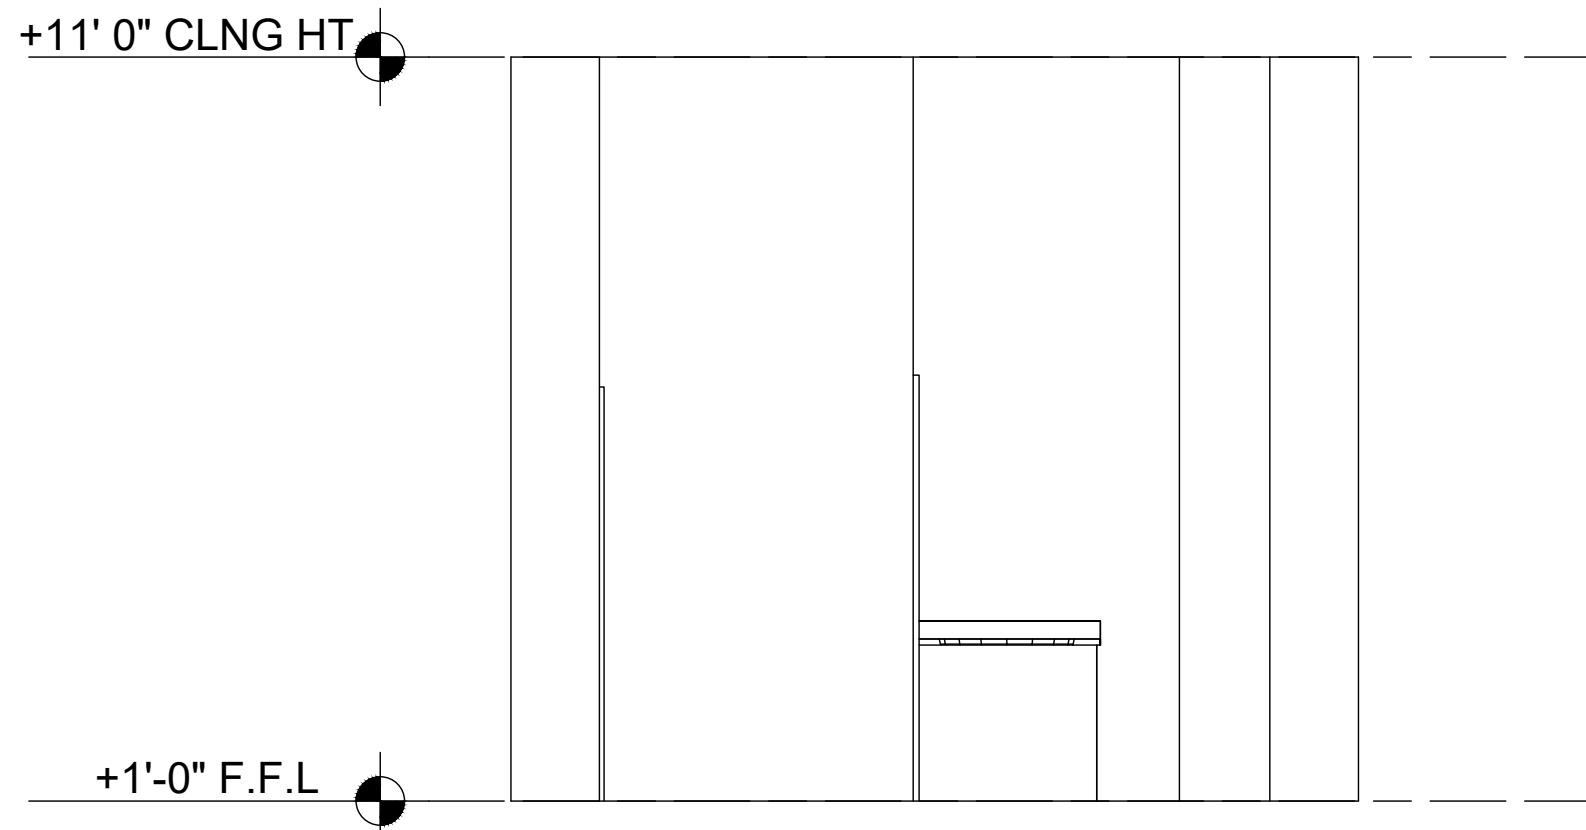

4.4 INTERIOR ELEVATION
SCALE: 3/8"=1'-0"

Notes:

1. ALL PLANS ARE CREATED BY REALTY 360° VIEW AND MADE EXCLUSIVELY FOR REAL ESTATE MARKETING PURPOSES.

ABBREVIATIONS


T.O.P	TOP OF PARAPET
B.O.J	BOTTOM OF JOIST
B.O.D	BOTTOM OF DUCT
B.O.D	BOTTOM OF DUCT
F.F.L	FINISH FLOOR LINE
N.G.L	NATURAL GRADE LINE
CLNG HT	CEILING HEIGHT

0	ISSUED FOR INFORMATION	RGE	9/12/20
REV:	DESCRIPTION:	BY:	DATE:

STATUS: AS-BUILT

REALTOR/BROKERAGE:

JAY MODGLIN
 Mobile: (303) 472-2150
 Office: (303) 820-2489
 Email: jay@kentwood.com
 Web: <http://www.jaymodglin.com/>

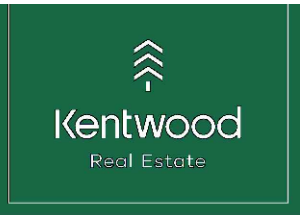

PRESENTED BY:


REALTY 360° VIEW
 Call or Text Us at: 720-770-1230
 Email Direct at: CR@Realty360View.com
 Website: <https://realty360view.com/>
 Address: 242 Linden St Fort Collins, CO 80524



SITE: 1430 W 37th Ave Denver, Co 80211, USA

TITLE: AS-BUILT DRAWING

SCALE: NTS	DATE: 09/12/20	DRAWN: RGE	APPROVED:
PROJECT NO: Prop.Tours/y36	SHEET NO: 4/7	REVISION: 0	

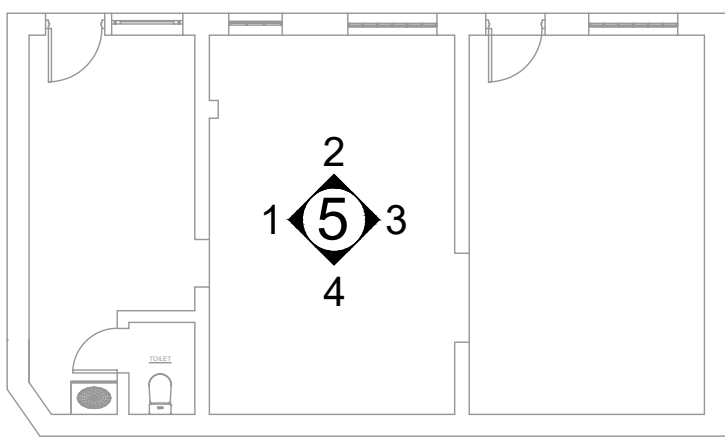

KEYPLAN

+11' 0" CLNG HT

+0'-8" F.F.L

5.1 INTERIOR ELEVATION
SCALE:3/8"=1'-0"

6'-6 1/2"

+11' 0" CLNG HT

+11' 0" CLNG HT

+0'-8" F.F.L

+0'-8" F.F.L

5.2 INTERIOR ELEVATION
SCALE:3/8"=1'-0"

5.4 INTERIOR ELEVATION
SCALE:3/8"=1'-0"

5'-2"
4'

+11' 0" CLNG HT

+0'-8" F.F.L

5.3 INTERIOR ELEVATION
SCALE:3/8"=1'-0"

5'-2"
4'

6'-6 1/2"

Notes:

1. ALL PLANS ARE CREATED BY REALTY 360° VIEW AND MADE EXCLUSIVELY FOR REAL ESTATE MARKETING PURPOSES.

ABBREVIATIONS

T.O.P	TOP OF PARAPET
B.O.J	BOTTOM OF JOIST
B.O.D	BOTTOM OF DUCT
B.O.D	BOTTOM OF DUCT
F.F.L	FINISH FLOOR LINE
N.G.L	NATURAL GRADE LINE
CLNG HT	CEILING HEIGHT

0	ISSUED FOR INFORMATION	RGE	9/12/20
REV:	DESCRIPTION:	BY:	DATE:

STATUS: AS-BUILT

REALTOR/BROKERAGE:

JAY MODGLIN
 Mobile: (303) 472-2150
 Office: (303) 820-2489
 Email: jay@kentwood.com
 Web: <http://www.jaymodglin.com/>



PRESENTED BY:


REALTY 360° VIEW
 Call or Text Us at: 720-770-1230
 Email Direct at: CR@Realty360View.com
 Website: <https://realty360view.com/>
 Address: 242 Linden St Fort Collins, CO 80524



SITE/: 1430 W 37th Ave Denver, Co 80211, USA

TITLE: AS-BUILT DRAWING


SCALE: NTS	DATE: 09/12/20	DRAWN: RGE	APPROVED:
PROJECT NO: Prop.Tours/y36	SHEET NO: 5/7	REVISION: 0	

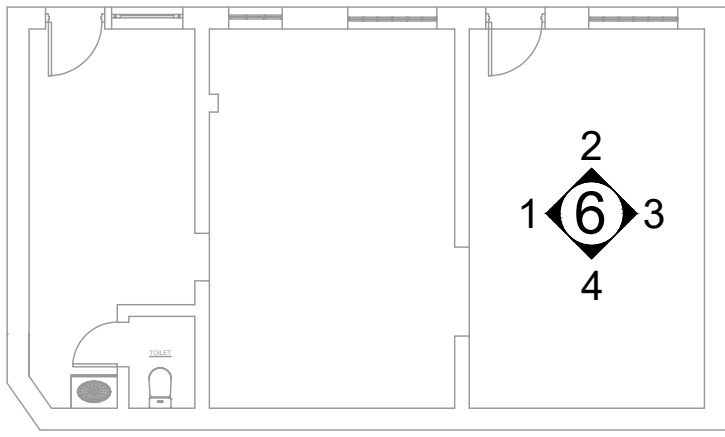

KEYPLAN

+11' 0" CLNG HT

+0'-4" F.F.L

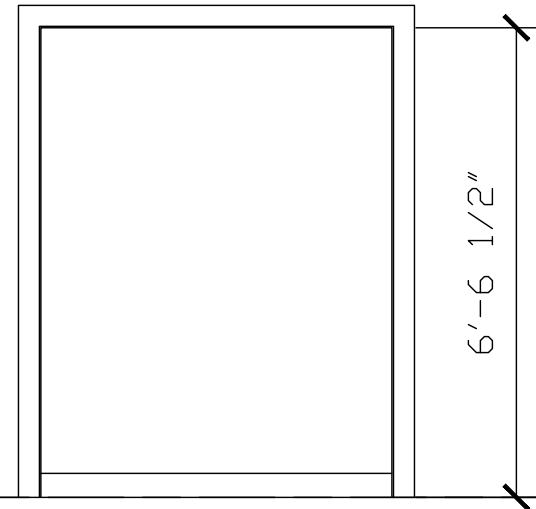


6.1 INTERIOR ELEVATION
SCALE:3/8"=1'-0"

+11' 0" CLNG HT

+11' 0" CLNG HT

+0'-4" F.F.L

+0'-4" F.F.L

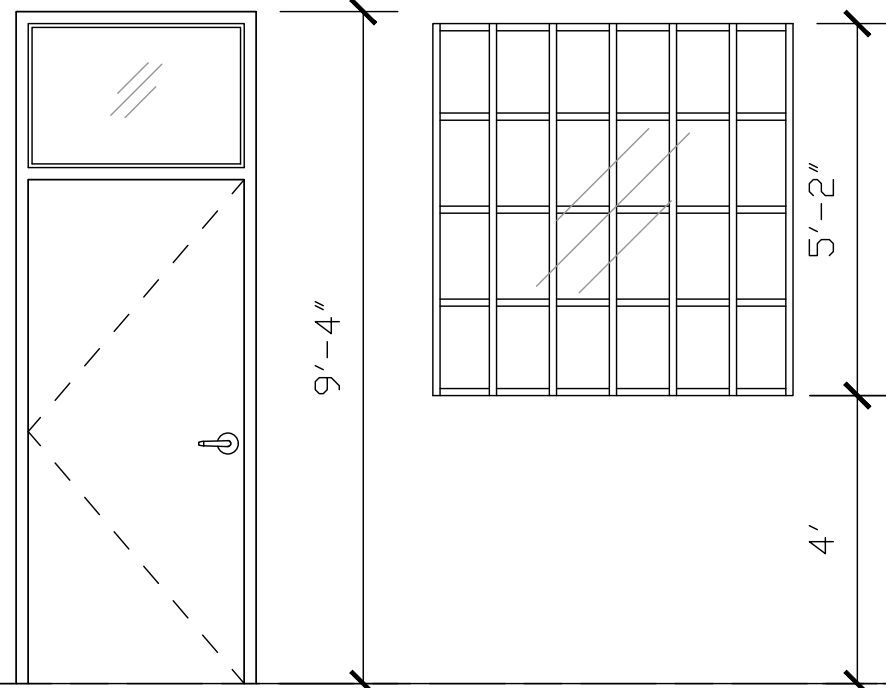

6.2 INTERIOR ELEVATION
SCALE:3/8"=1'-0"

6.4 INTERIOR ELEVATION
SCALE:3/8"=1'-0"

+11' 0" CLNG HT

+0'-4" F.F.L



6.3 INTERIOR ELEVATION
SCALE:3/8"=1'-0"

Notes:

1. ALL PLANS ARE CREATED BY REALTY 360° VIEW AND MADE EXCLUSIVELY FOR REAL ESTATE MARKETING PURPOSES.

ABBREVIATIONS

T.O.P	TOP OF PARAPET
B.O.J	BOTTOM OF JOIST
B.O.D	BOTTOM OF DUCT
B.O.D	BOTTOM OF DUCT
F.F.L	FINISH FLOOR LINE
N.G.L	NATURAL GRADE LINE
CLNG HT	CEILING HEIGHT

0	ISSUED FOR INFORMATION	RGE	9/12/20
REV:	DESCRIPTION:	BY:	DATE:

STATUS: AS-BUILT

REALTOR/BROKERAGE:

JAY MODGLIN
 Mobile: (303) 472-2150
 Office: (303) 820-2489
 Email: jay@kentwood.com
 Web: <http://www.jaymodglin.com/>



PRESENTED BY:

REALTY 360° VIEW
 Call or Text Us at: 720-770-1230
 Email Direct at: CR@Realty360View.com
 Website: <https://realty360view.com/>
 Address: 242 Linden St Fort Collins, CO 80524




SITE/: 1430 W 37th Ave Denver, Co 80211, USA

TITLE: AS-BUILT DRAWING

SCALE: NTS	DATE: 09/12/20	DRAWN: RGE	APPROVED:
PROJECT NO: Prop.Tours/y36	SHEET NO: 6/7	REVISION: 0	

Notes:

1. ALL PLANS ARE CREATED BY REALTY 360° VIEW AND MADE EXCLUSIVELY FOR REAL ESTATE MARKETING PURPOSES.

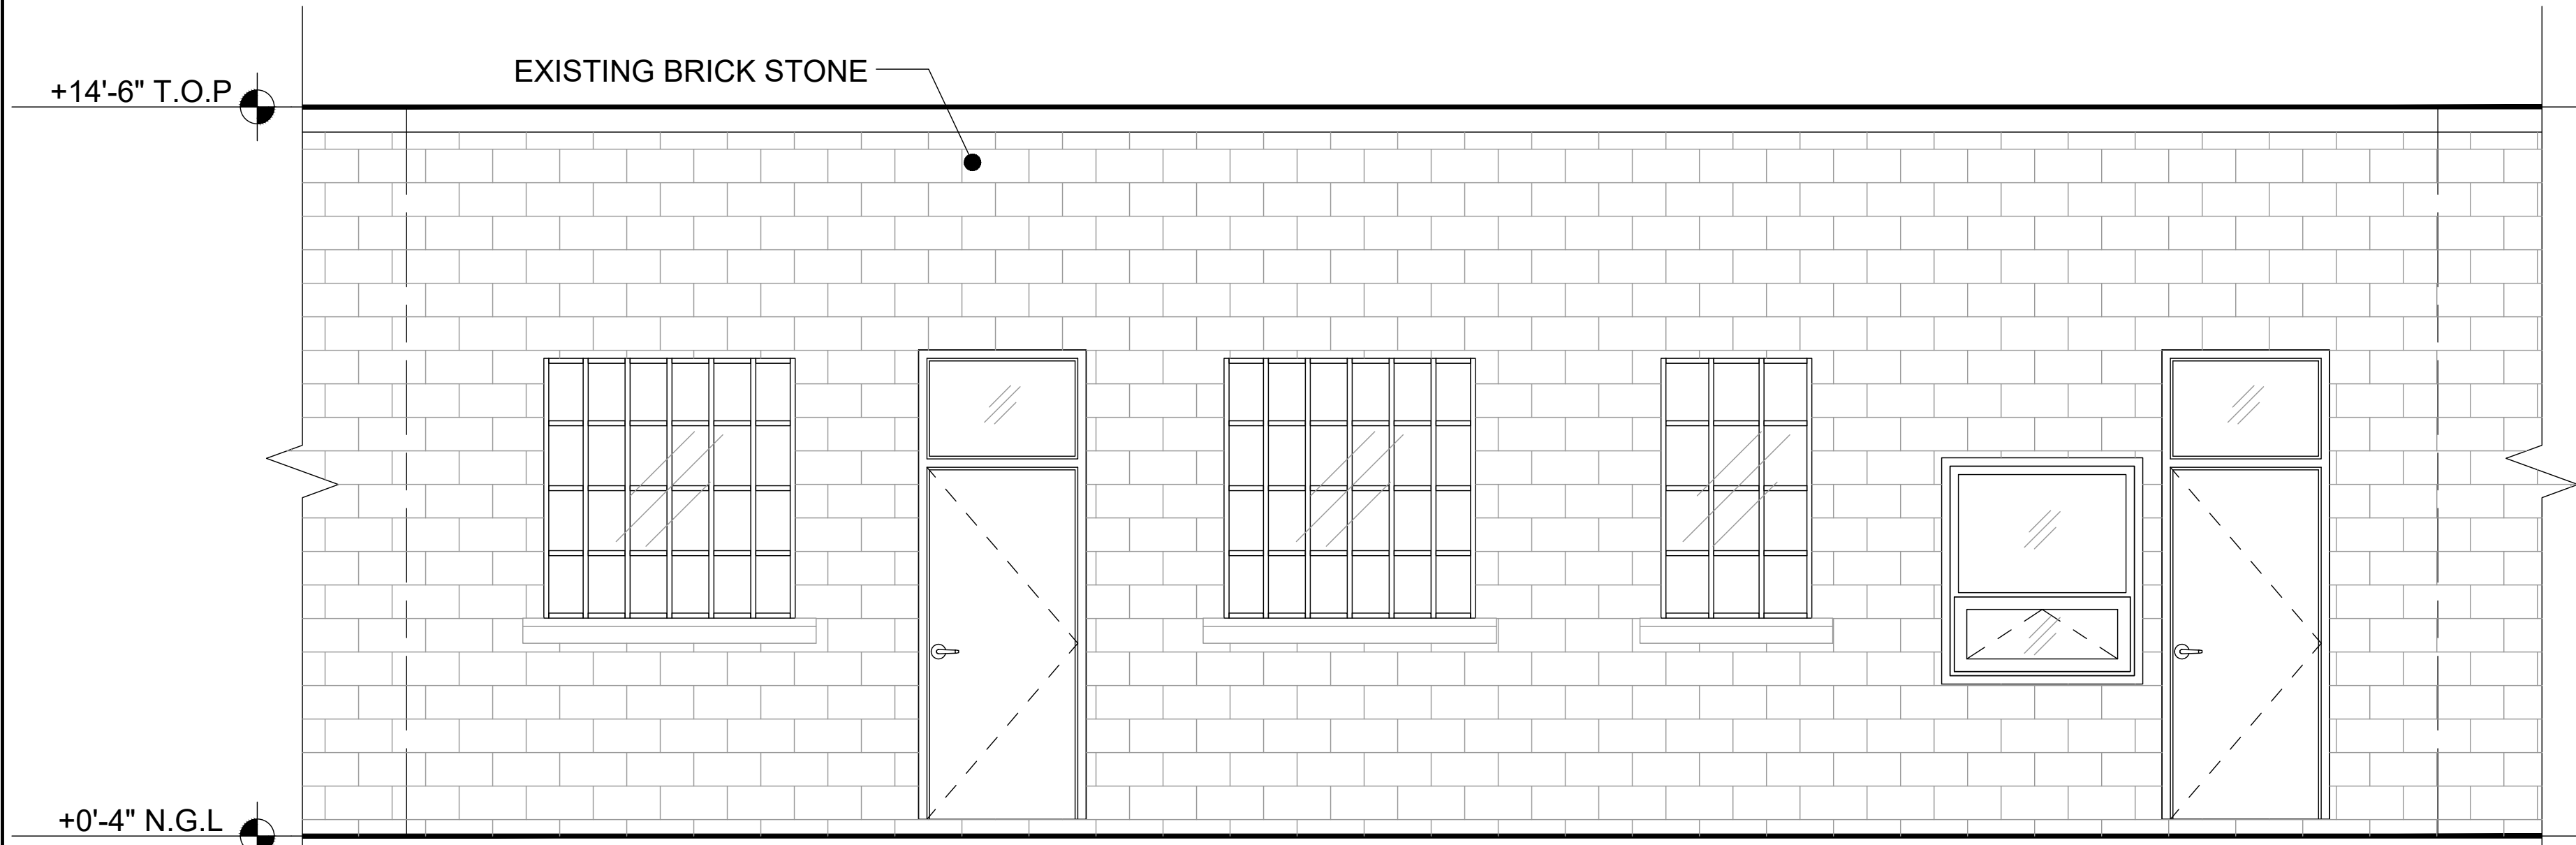

6.3 EXTERIOR ELEVATION
SCALE: 3/8" = 1'-0"

ABBREVIATIONS

T.O.P	TOP OF PARAPET
B.O.J	BOTTOM OF JOIST
B.O.D	BOTTOM OF DUCT
B.O.D	BOTTOM OF DUCT
F.F.L	FINISH FLOOR LINE
N.G.L	NATURAL GRADE LINE
CLNG HT	CEILING HEIGHT

0	ISSUED FOR INFORMATION	RGE	9/12/20
REV:	DESCRIPTION:	BY:	DATE:

STATUS: AS-BUILT

REALTOR/BROKERAGE:

JAY MODGLIN
 Mobile: (303) 472-2150
 Office: (303) 820-2489
 Email: jay@kentwood.com
 Web: http://www.jaymodglin.com/



PRESENTED BY:

REALTY 360° VIEW
 Call or Text Us at: 720-770-1230
 Email Direct at: CR@Realty360View.com
 Website: https://realty360view.com/
 Address: 242 Linden St Fort Collins, CO 80524



SITE/: 1430 W 37th Ave Denver, Co 80211, USA

TITLE: AS-BUILT DRAWING

SCALE: NTS	DATE: 09/12/20	DRAWN: RGE	APPROVED:
PROJECT NO: Prop.Tours/y36	SHEET NO: 7/7	REVISION: 0	