

LOCATION MAP



STREET VIEW

Notes:

1. ALL PLANS ARE CREATED BY REALTY 360° VIEW AND MADE EXCLUSIVELY FOR REAL ESTATE MARKETING PURPOSES.
 2. SIZED AND DIMENSIONS ARE APPROXIMATE. ACTUAL MAY VARY.

1	ISSUED FOR INFORMATION	RGE	10/21/20
REV:	DESCRIPTION:	BY:	DATE:

STATUS: **AS-BUILT**

REALTOR/BROKERAGE:
KYLE LUNDY
 Mobile: (970) 443-2900
 Office: (970) 225-5152
 Email: kylelundy@c3-re.com
<https://c3realestatesolutions.com/realtor/kyle-lundy/>





PRESENTED BY:
REALTY 360° VIEW
 Call or Text Us at: 720-770-1230
 Email Direct at: CR@Realty360View.com
 Website: <https://realty360view.com/>
 Address: 242 Linden St Fort Collins, CO 80524



SITE/LOCATION:
 300-312 N Lincoln Ave Loveland, CO 80537

TITLE:
 AS-BUILT DRAWING


SCALE: NTS	DATE: 10/21/20	DRAWN: RGE	APPROVED: RGE
PROJECT NO: Prop.Tours/a4b	SHEET NO: 1/4	PHASE: 1	

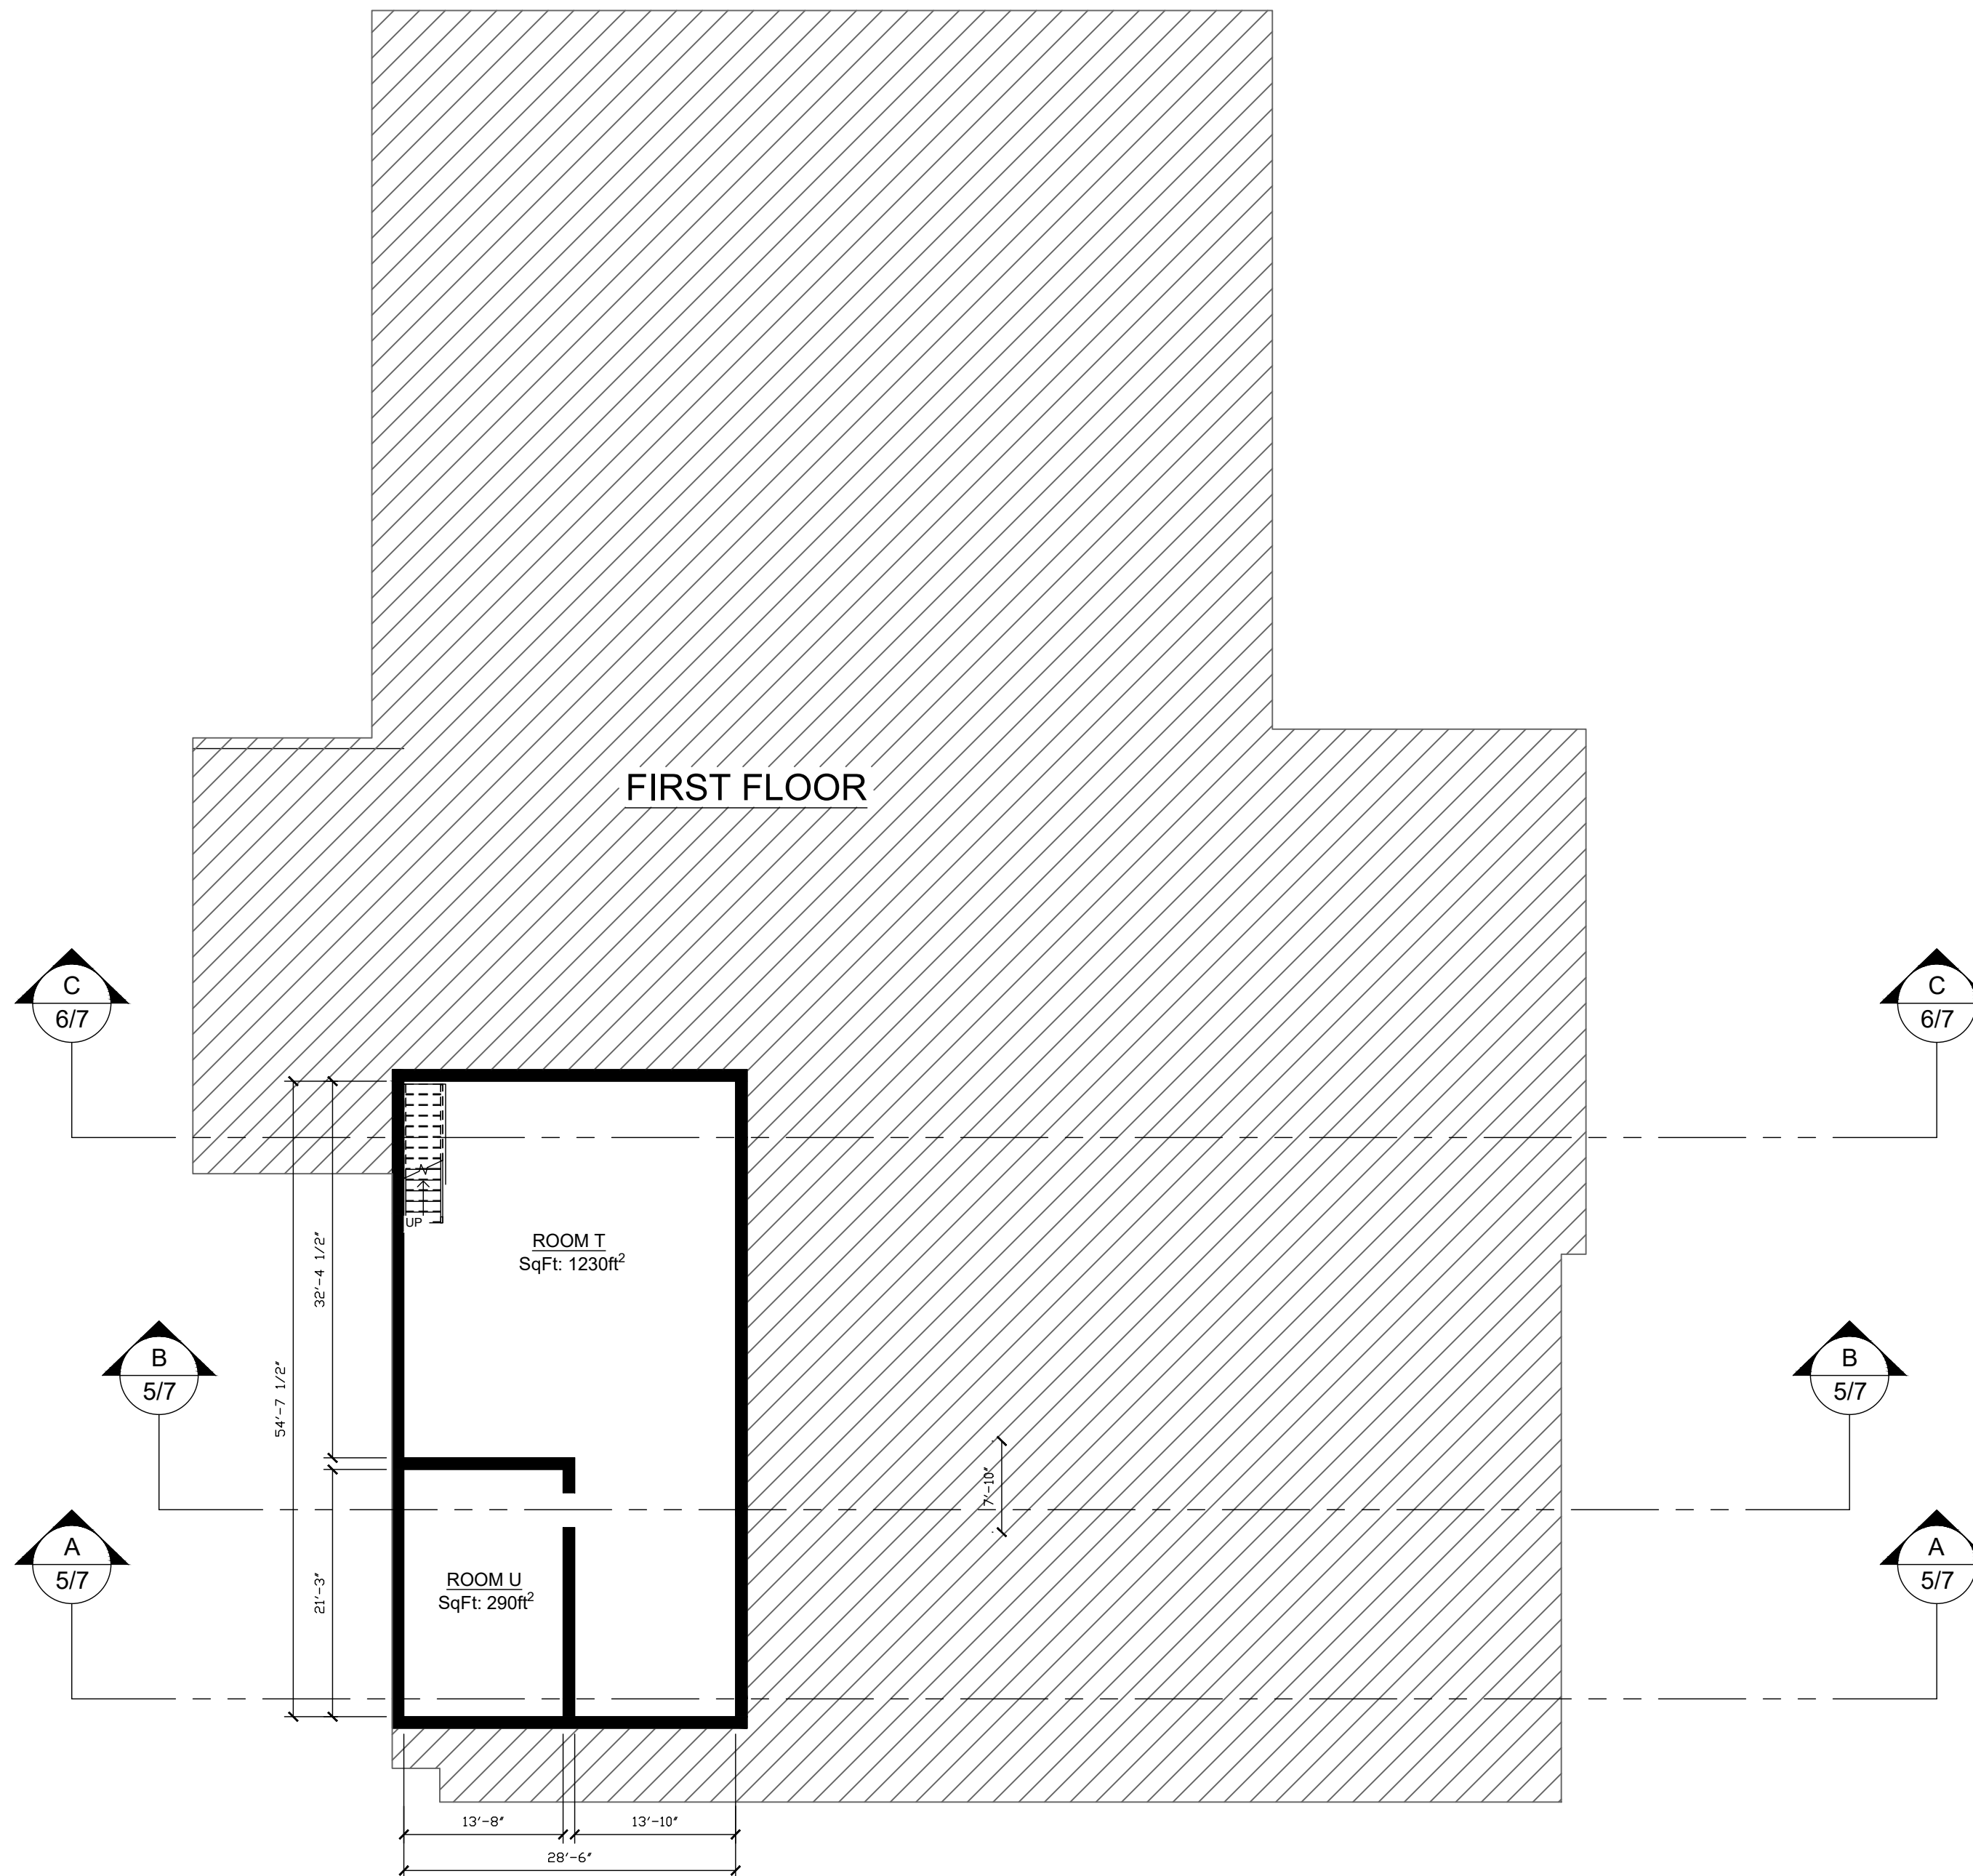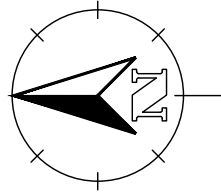

A BASEMENT FLOOR PLAN
2/7 SCALE: 1/12"=1'-0"

Notes:

1. ALL PLANS ARE CREATED BY REALTY 360° VIEW AND MADE EXCLUSIVELY FOR REAL ESTATE MARKETING PURPOSES.
2. SIZED AND DIMENSIONS ARE APPROXIMATE. ACTUAL MAY VARY.

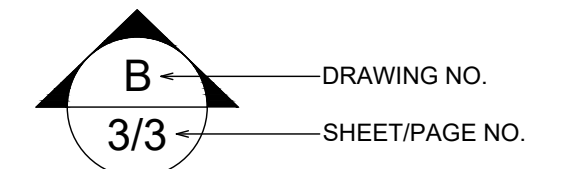

WALL LEGEND

EXISTING WALL

ABBREVIATIONS

T.O.P	TOP OF PARAPET
B.O.J	BOTTOM OF JOIST
B.O.D	BOTTOM OF DUCT
B.O.D	BOTTOM OF DUCT
F.F.L	FINISH FLOOR LINE
N.G.L	NATURAL GRADE LINE
CH	CEILING HEIGHT

1	ISSUED FOR INFORMATION	RGE	10/21/20
REV:	DESCRIPTION:	BY:	DATE:

STATUS: **AS-BUILT**

REALTOR/BROKERAGE:

KYLE LUNDY
 Mobile: (970) 443-2900
 Office: (970) 225-5152
 Email: kylelundy@c3-re.com
<https://c3realestatesolutions.com/realtor/kyle-lundy/>



PRESENTED BY:



REALTY 360° VIEW
 Call or Text Us at: 720-770-1230
 Email Direct at: CR@Realty360View.com
 Website: <https://realty360view.com/>
 Address: 242 Linden St Fort Collins, CO 80524



SITE/LOCATION:
 300-312 N Lincoln Ave Loveland, CO 80537

TITLE:
 AS-BUILT DRAWING

SCALE: 1/12"=1'-0"	DATE: 10/21/20	DRAWN: RGE	APPROVED: RGE
PROJECT NO: Prop.Tours/a4b	SHEET NO: 2/7	PHASE: 1	

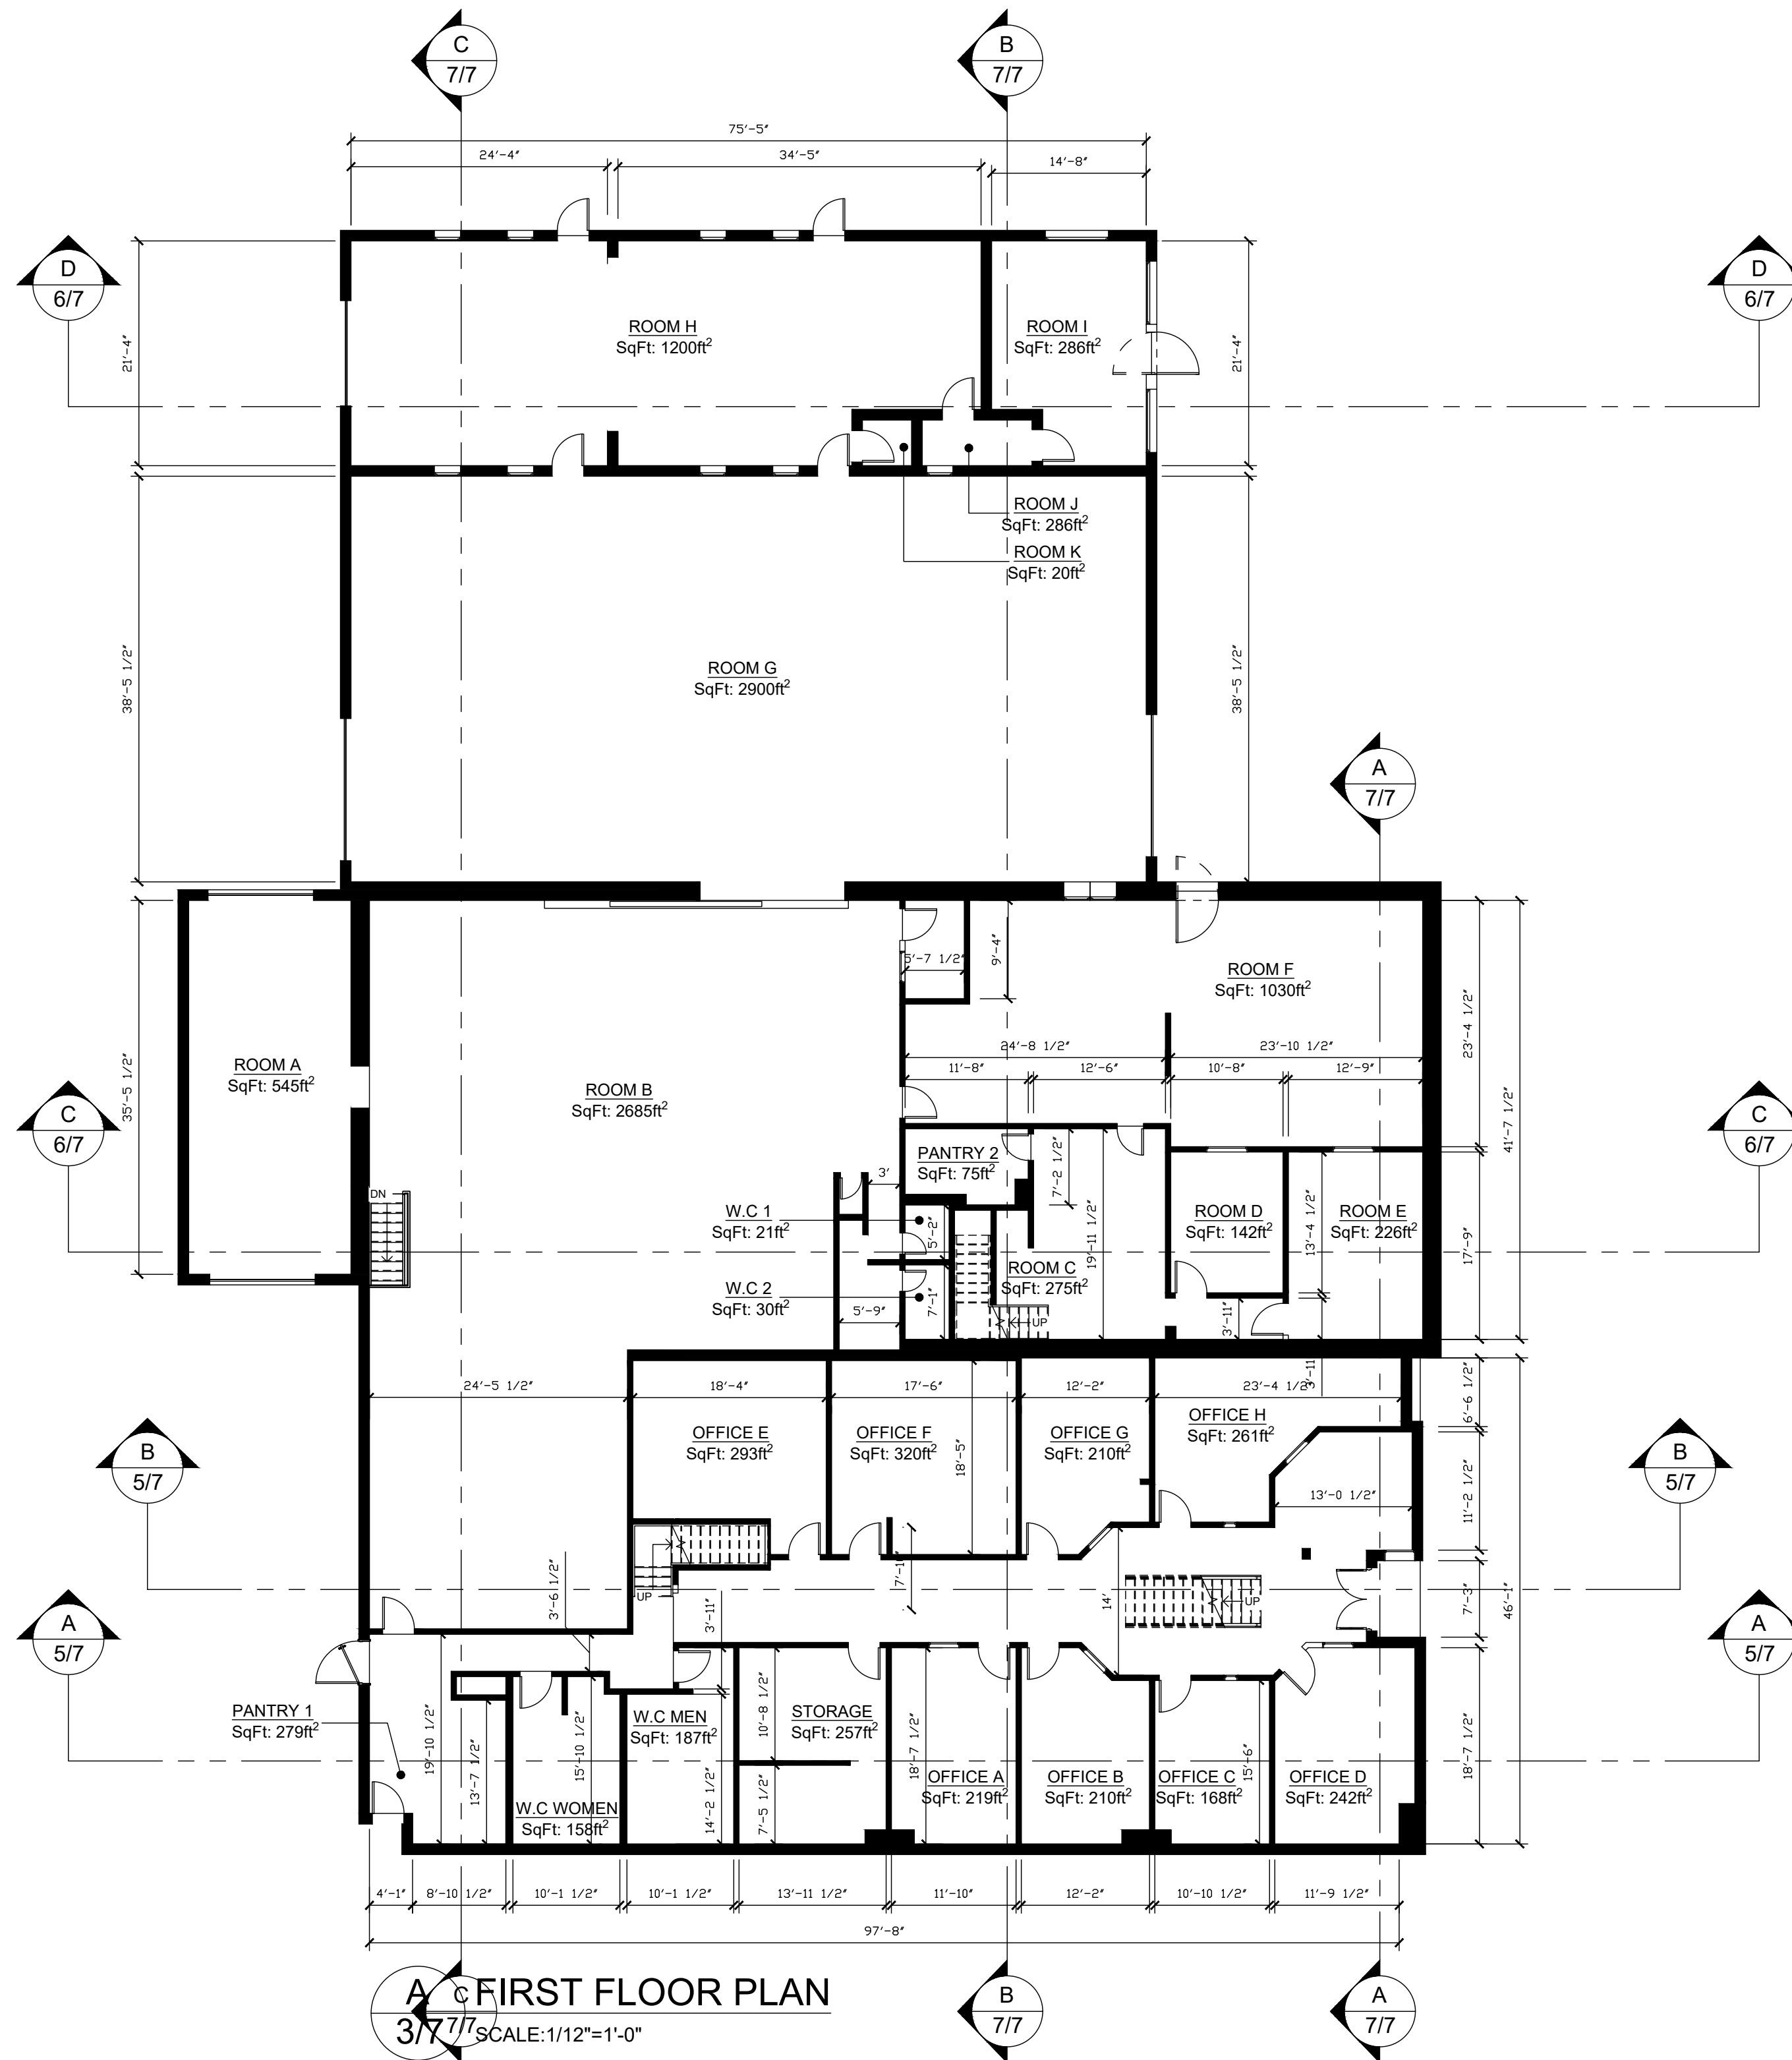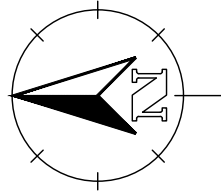

3/7 7/7
SCALE: 1/12" = 1'-0"

Notes:

1. ALL PLANS ARE CREATED BY REALTY 360° VIEW AND MADE EXCLUSIVELY FOR REAL ESTATE MARKETING PURPOSES.
2. SIZED AND DIMENSIONS ARE APPROXIMATE. ACTUAL MAY VARY.

B ← DRAWING NO.
3/3 ← SHEET/PAGE NO.

WALL LEGEND

	EXISTING WALL
ABBREVIATIONS	
T.O.P	TOP OF PARAPET
B.O.J	BOTTOM OF JOIST
B.O.D	BOTTOM OF DUCT
B.O.D	BOTTOM OF DUCT
F.F.L	FINISH FLOOR LINE
N.G.L	NATURAL GRADE LINE
CH	CEILING HEIGHT

1	ISSUED FOR INFORMATION	RGE	10/21/20
REV:	DESCRIPTION:	BY:	DATE:

STATUS: **AS-BUILT**

REALTOR/BROKERAGE:
KYLE LUNDY
 Mobile: (970) 443-2900
 Office: (970) 225-5152
 Email: kylelundy@c3-re.com
<https://c3realestatesolutions.com/realtor/kyle-lundy/>





PRESENTED BY:
REALTY 360° VIEW
 Call or Text Us at: 720-770-1230
 Email Direct at: CR@Realty360View.com
 Website: <https://realty360view.com/>
 Address: 242 Linden St Fort Collins, CO 80524



SITE/LOCATION:
 300-312 N Lincoln Ave Loveland, CO 80537

TITLE:
 AS-BUILT DRAWING


SCALE: 1/12" = 1'-0"	DATE: 10/21/20	DRAWN: RGE	APPROVED: RGE
PROJECT NO: Prop.Tours/a4b	SHEET NO: 3/7	PHASE: 1	

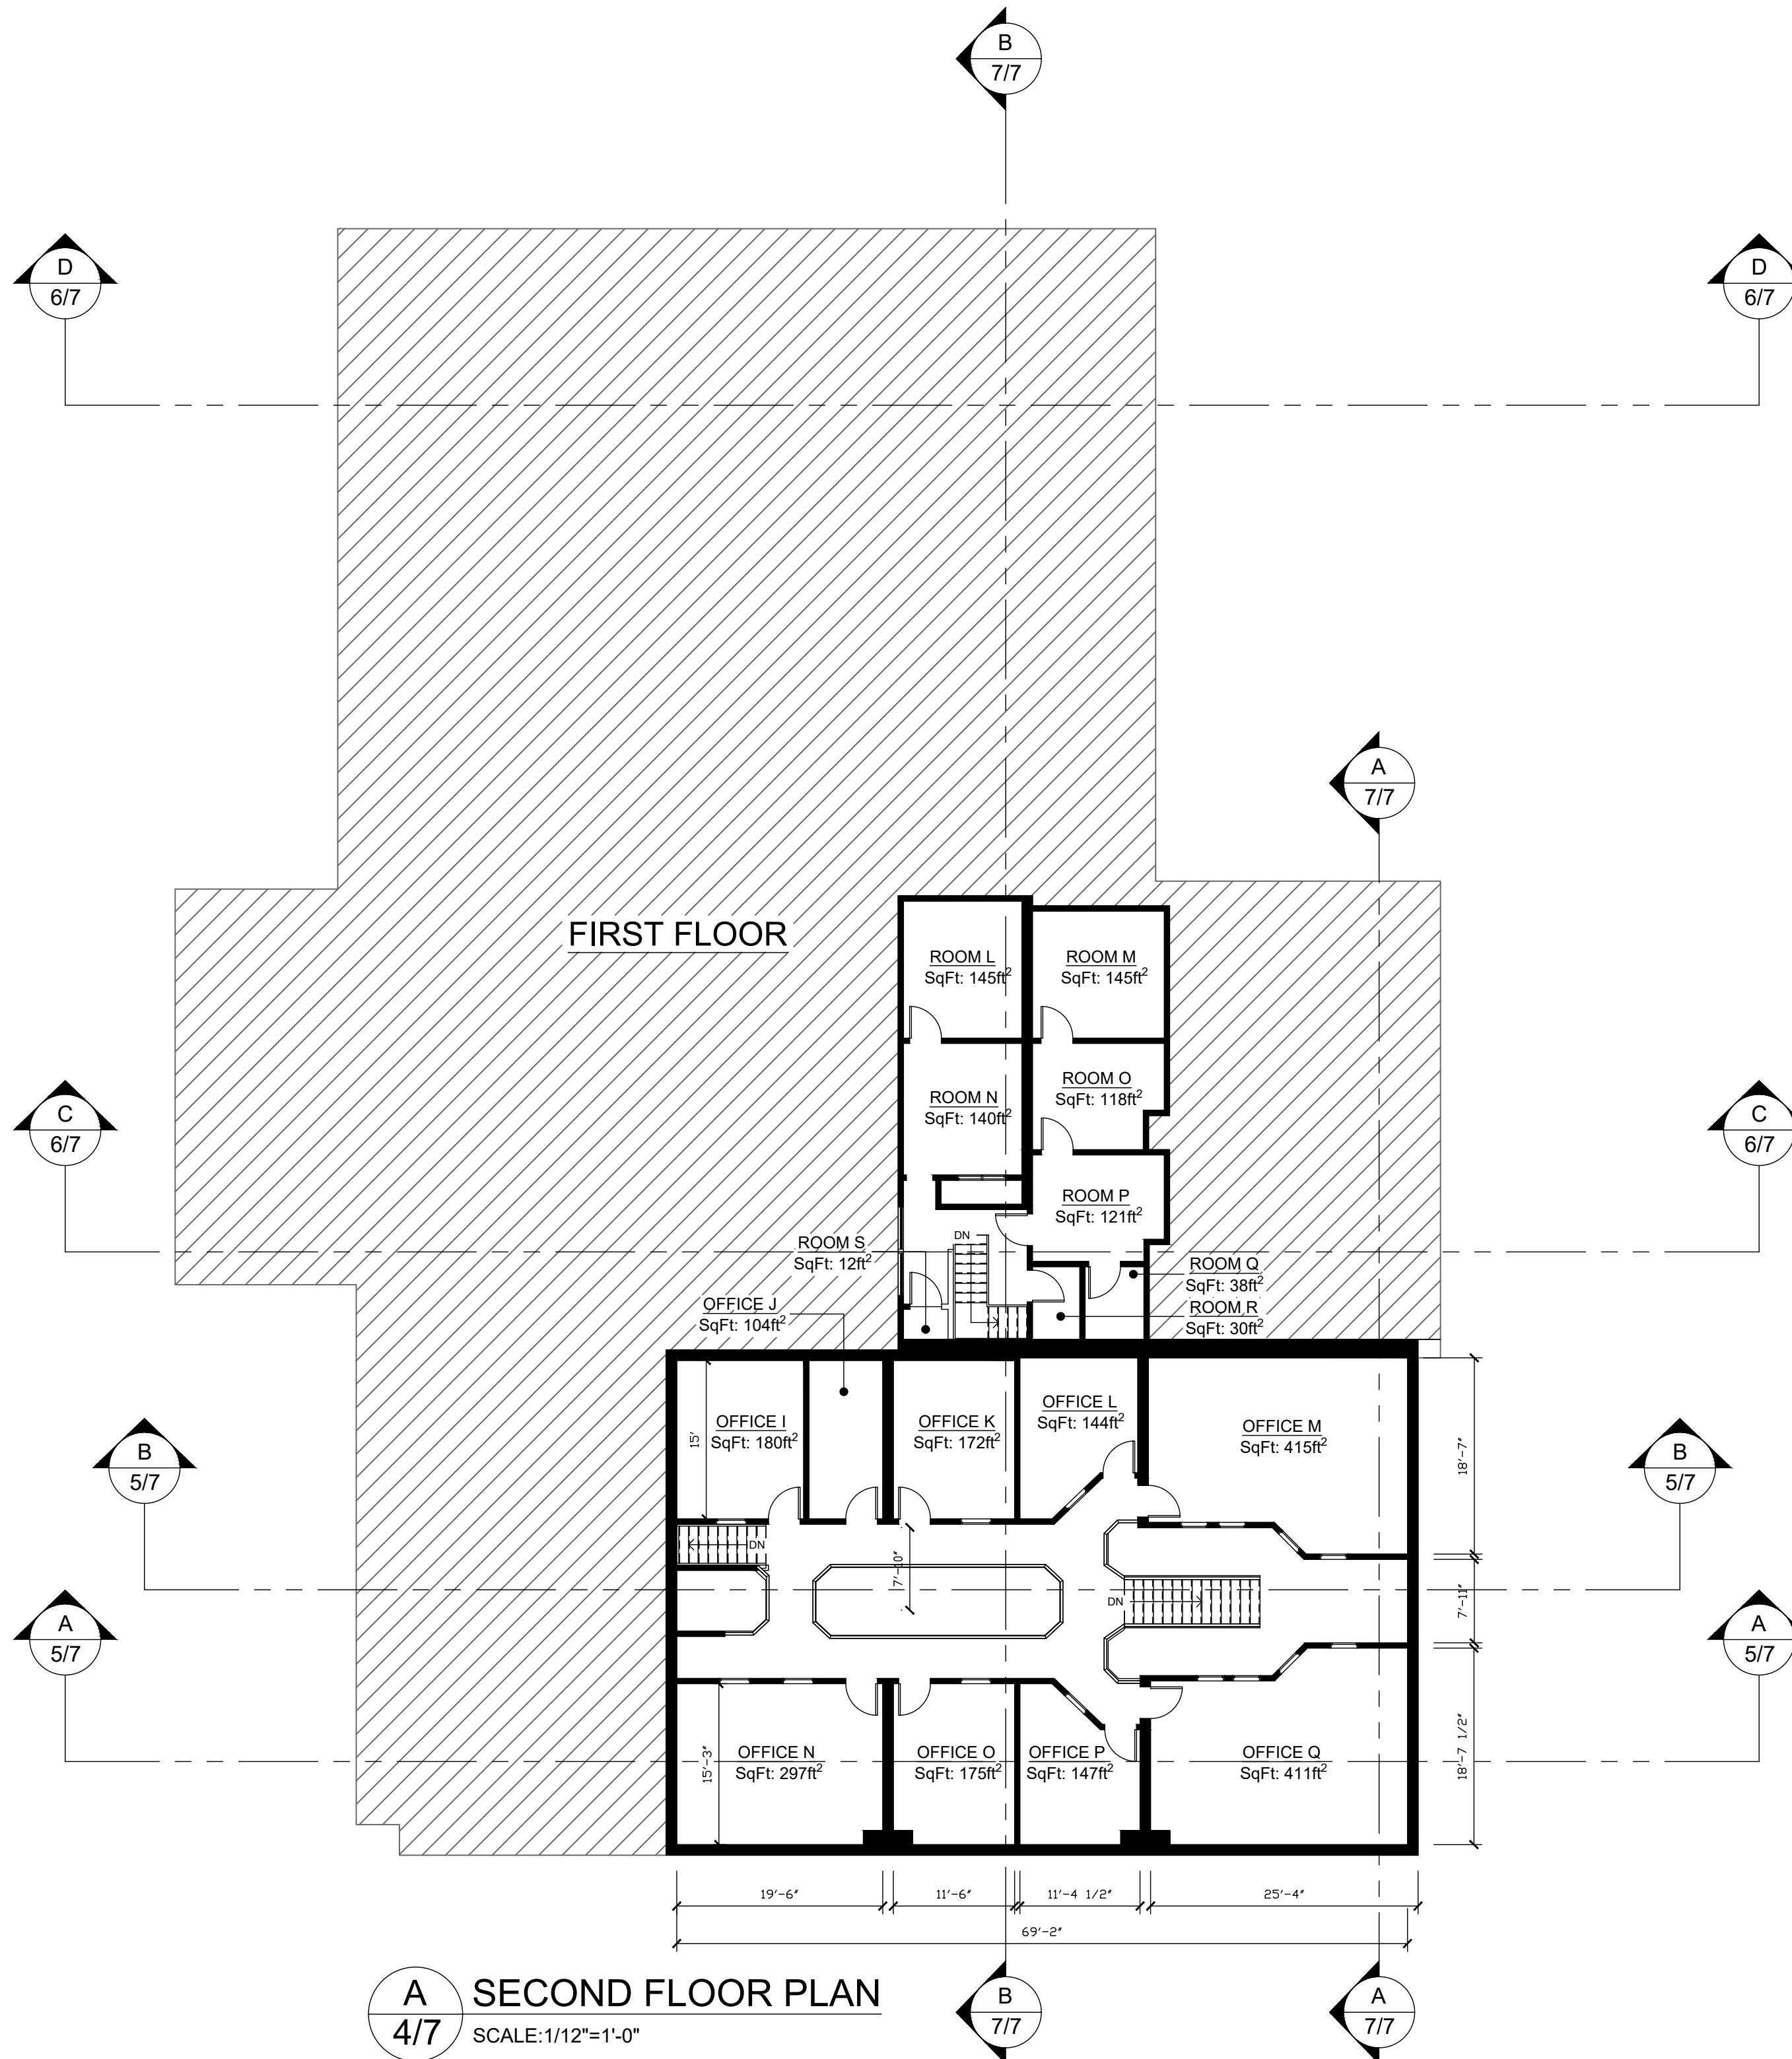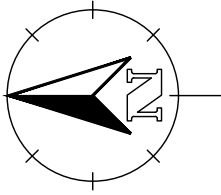

A
4/7 **SECOND FLOOR PLAN**
SCALE: 1/12"=1'-0"

Notes:

1. ALL PLANS ARE CREATED BY REALTY 360° VIEW AND MADE EXCLUSIVELY FOR REAL ESTATE MARKETING PURPOSES.
2. SIZED AND DIMENSIONS ARE APPROXIMATE. ACTUAL MAY VARY.

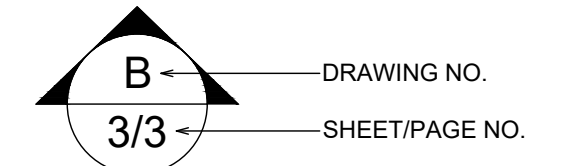

WALL LEGEND

EXISTING WALL

ABBREVIATIONS

T.O.P	TOP OF PARAPET
B.O.J	BOTTOM OF JOIST
B.O.D	BOTTOM OF DUCT
B.O.D	BOTTOM OF DUCT
F.F.L	FINISH FLOOR LINE
N.G.L	NATURAL GRADE LINE
CH	CEILING HEIGHT

1	ISSUED FOR INFORMATION	RGE	10/21/20
REV:	DESCRIPTION:	BY:	DATE:

STATUS: **AS-BUILT**

REALTOR/BROKERAGE:

KYLE LUNDY
 Mobile: (970) 443-2900
 Office: (970) 225-5152
 Email: kylelundy@c3-re.com
<https://c3realestatesolutions.com/realtor/kyle-lundy/>



PRESENTED BY:

REALTY 360° VIEW
 Call or Text Us at: 720-770-1230
 Email Direct at: CR@Realty360View.com
 Website: <https://realty360view.com/>
 Address: 242 Linden St Fort Collins, CO 80524




SITE/LOCATION:
300-312 N Lincoln Ave Loveland, CO 80537

TITLE:
AS-BUILT DRAWING


SCALE: 1/12"=1'-0"	DATE: 10/21/20	DRAWN: RGE	APPROVED: RGE
PROJECT NO: Prop.Tours/a4b	SHEET NO: 4/7	PHASE: 1	

Notes:

1. ALL PLANS ARE CREATED BY REALTY 360° VIEW AND MADE EXCLUSIVELY FOR REAL ESTATE MARKETING PURPOSES.
2. SIZED AND DIMENSIONS ARE APPROXIMATE. ACTUAL MAY VARY.

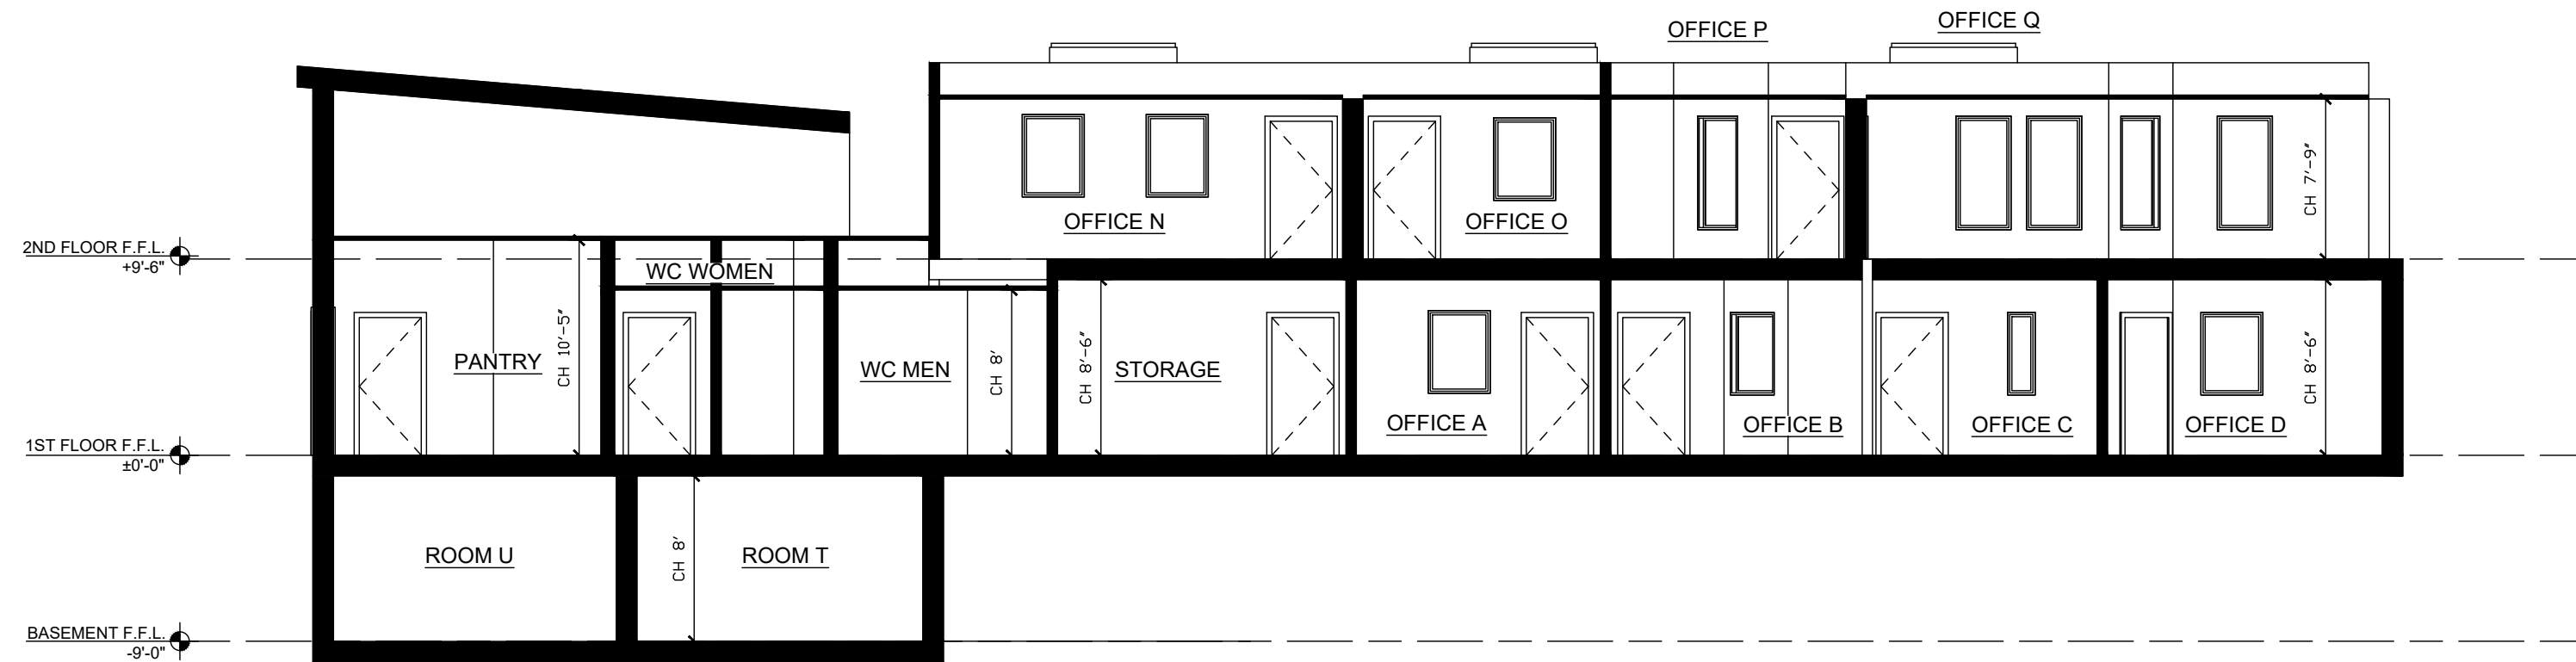

A LONGTITUDINAL SECTION A
5/7 SCALE: 1/8"=1'-0"

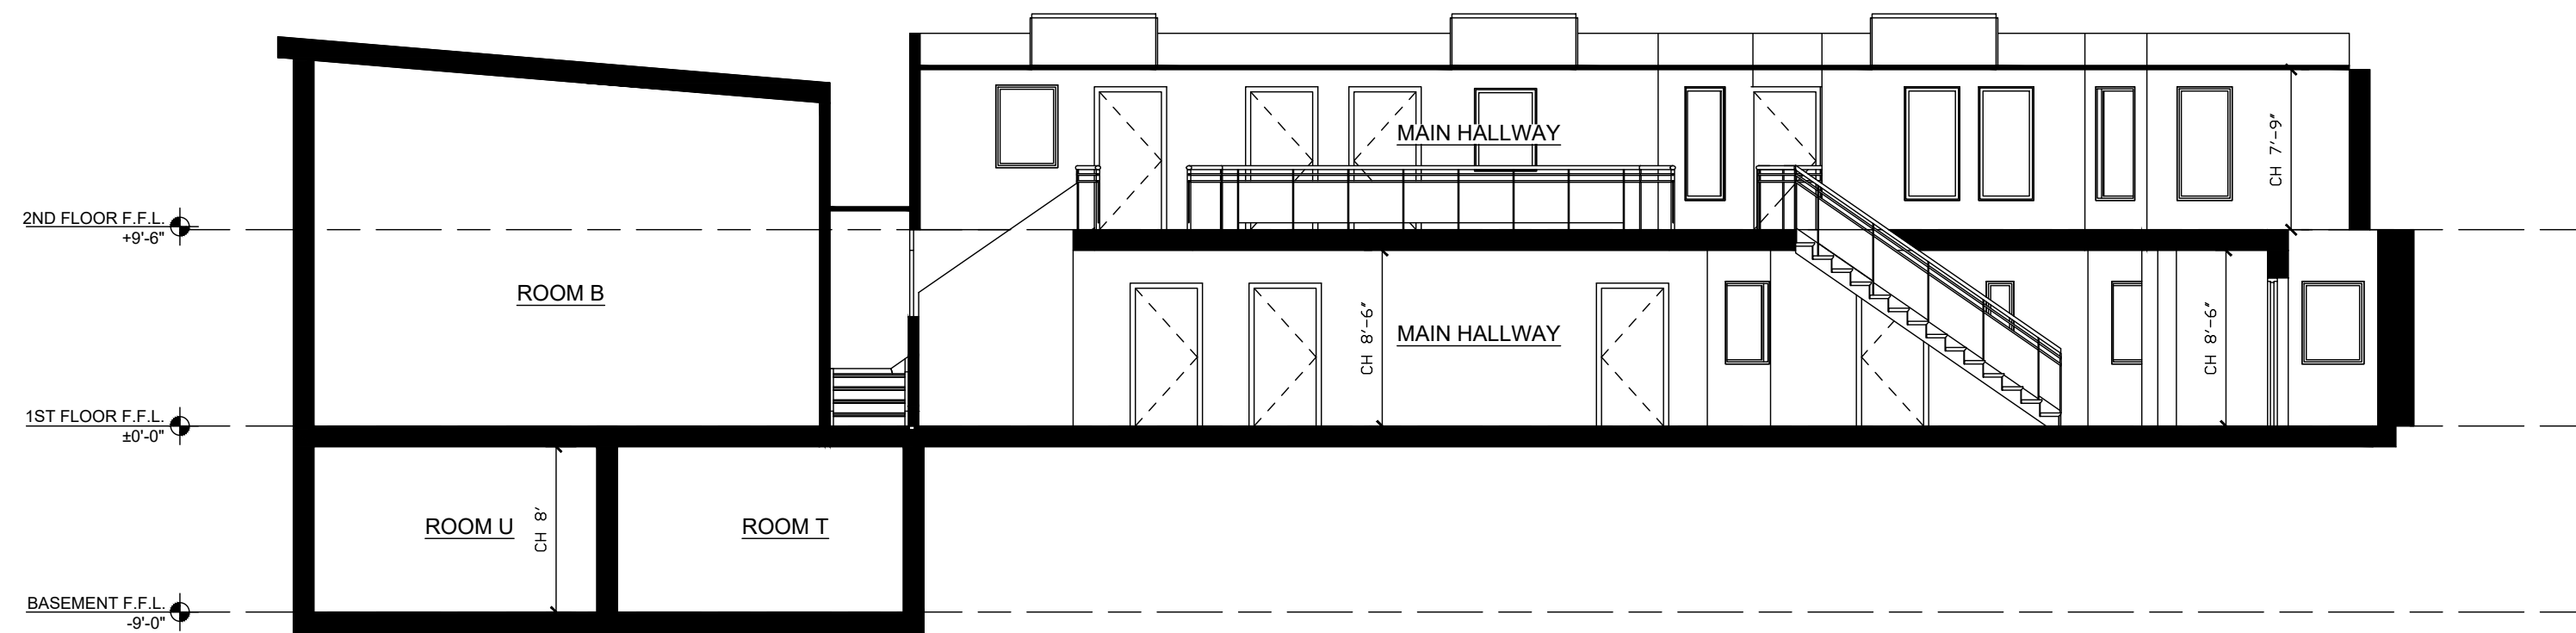

B LONGTITUDINAL SECTION B
5/7 SCALE: 1/8"=1'-0"

WALL LEGEND

EXISTING WALL

ABBREVIATIONS

T.O.P	TOP OF PARAPET
B.O.J	BOTTOM OF JOIST
B.O.D	BOTTOM OF DUCT
B.O.D	BOTTOM OF DUCT
F.F.L	FINISH FLOOR LINE
N.G.L	NATURAL GRADE LINE
CH	CEILING HEIGHT

1	ISSUED FOR INFORMATION	RGE	10/21/20
REV:	DESCRIPTION:	BY:	DATE:

STATUS: **AS-BUILT**

REALTOR/BROKERAGE:

KYLE LUNDY
 Mobile: (970) 443-2900
 Office: (970) 225-5152
 Email: kylelundy@c3-re.com
<https://c3realestatesolutions.com/realtor/kyle-lundy/>



PRESENTED BY:


REALTY 360° VIEW
 Call or Text Us at: 720-770-1230
 Email Direct at: CR@Realty360View.com
 Website: <https://realty360view.com/>
 Address: 242 Linden St Fort Collins, CO 80524




SITE/LOCATION:
300-312 N Lincoln Ave Loveland, CO 80537

TITLE:
AS-BUILT DRAWING

SCALE: 1/8" = 1'-0"	DATE: 10/21/20	DRAWN: RGE	APPROVED: RGE
PROJECT NO: Prop.Tours/a4b	SHEET NO: 5/7	PHASE: 1	

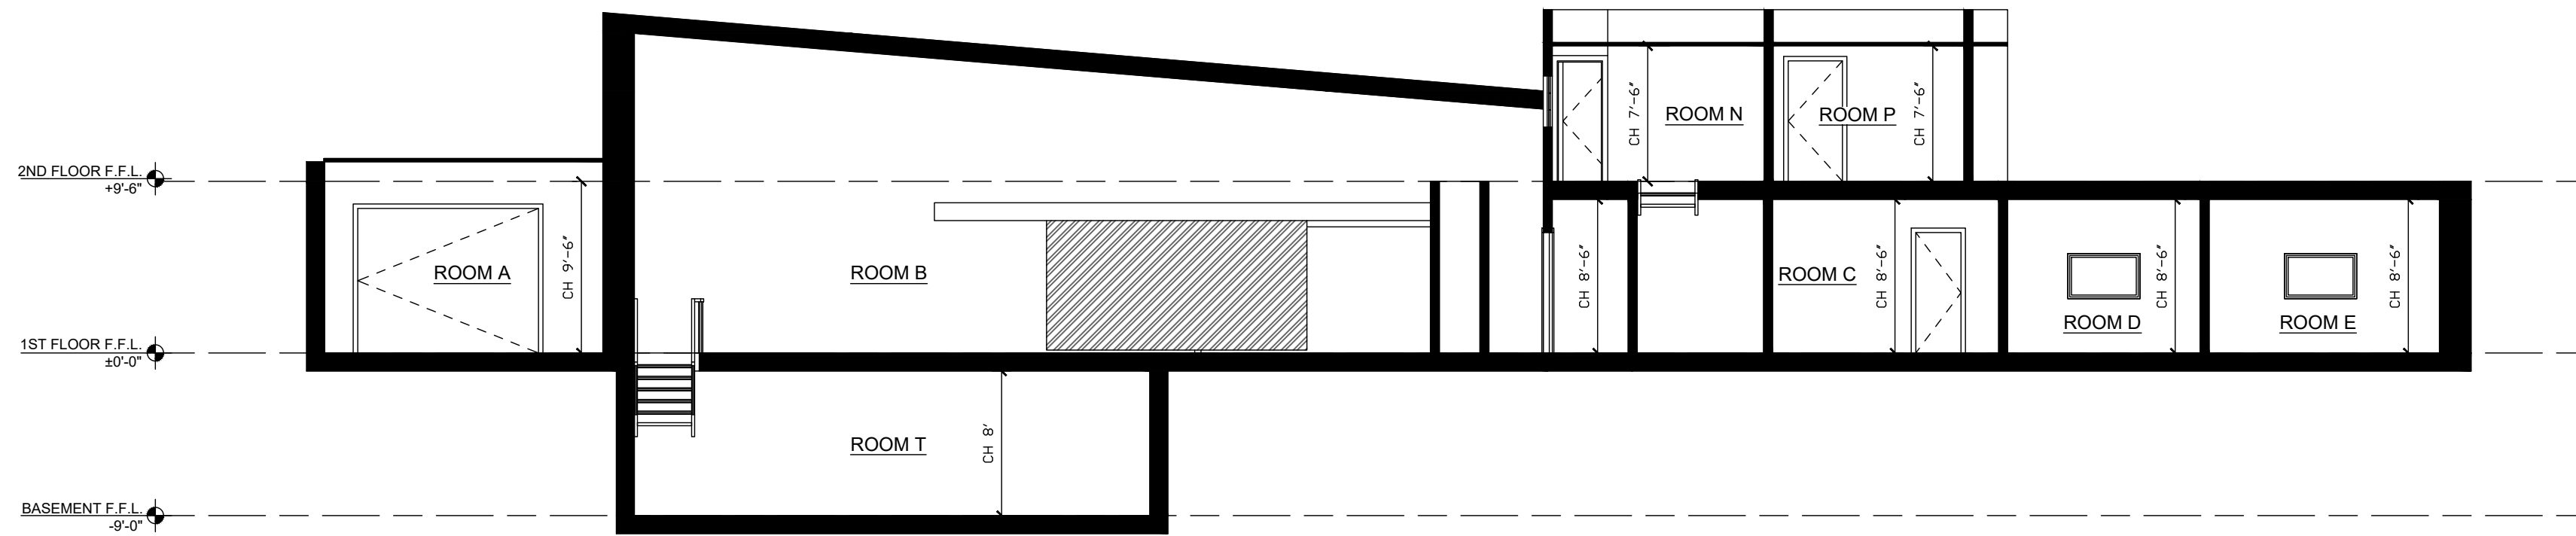

C LONGTITUDINAL SECTION C
6/7 SCALE: 1/8"=1'-0"

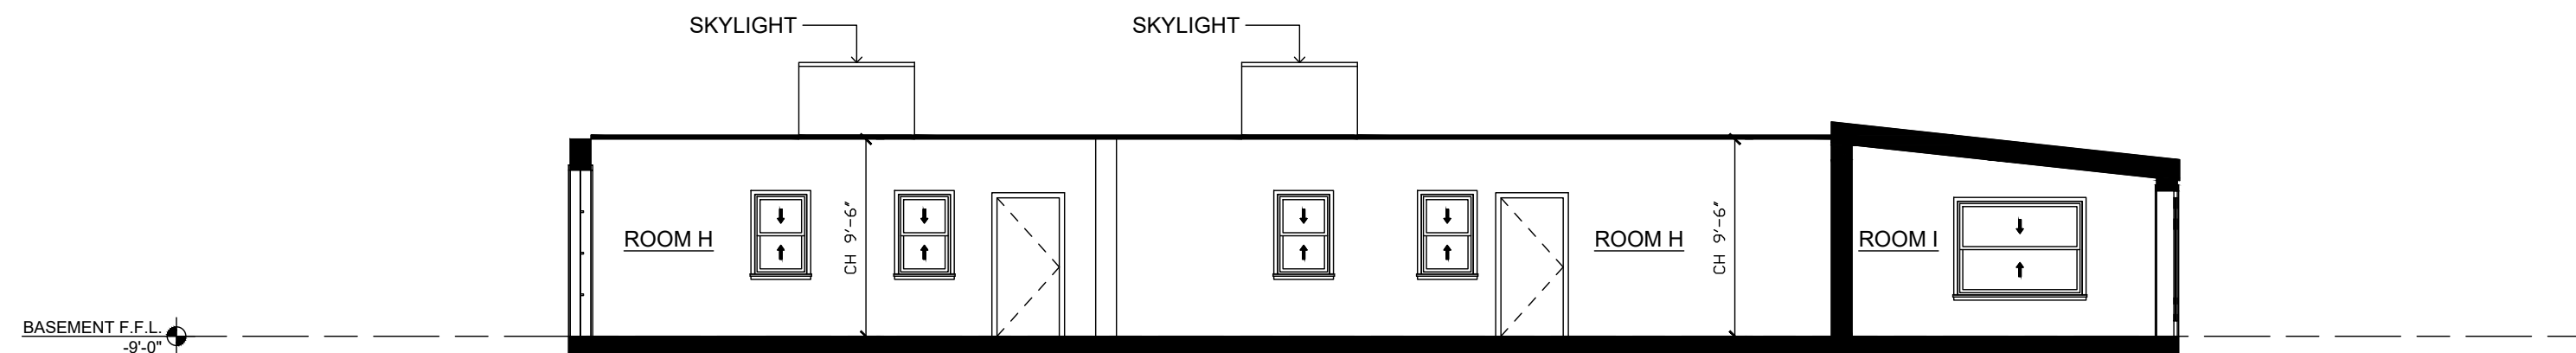

D LONGTITUDINAL SECTION D
6/7 SCALE: 1/8"=1'-0"

Notes:

1. ALL PLANS ARE CREATED BY REALTY 360° VIEW AND MADE EXCLUSIVELY FOR REAL ESTATE MARKETING PURPOSES.
2. SIZED AND DIMENSIONS ARE APPROXIMATE. ACTUAL MAY VARY.

WALL LEGEND

	EXISTING WALL
--	---------------

ABBREVIATIONS

T.O.P	TOP OF PARAPET
B.O.J	BOTTOM OF JOIST
B.O.D	BOTTOM OF DUCT
B.O.D	BOTTOM OF DUCT
F.F.L	FINISH FLOOR LINE
N.G.L	NATURAL GRADE LINE
CH	CEILING HEIGHT

1	ISSUED FOR INFORMATION	RGE	10/21/20
REV:	DESCRIPTION:	BY:	DATE:

STATUS: **AS-BUILT**

REALTOR/BROKERAGE:

KYLE LUNDY
 Mobile: (970) 443-2900
 Office: (970) 225-5152
 Email: kylelundy@c3-re.com
<https://c3realestatesolutions.com/realtor/kyle-lundy/>



PRESENTED BY:

REALTY 360° VIEW
 Call or Text Us at: 720-770-1230
 Email Direct at: CR@Realty360View.com
 Website: <https://realty360view.com/>
 Address: 242 Linden St Fort Collins, CO 80524




SITE/LOCATION:
300-312 N Lincoln Ave Loveland, CO 80537

TITLE:
AS-BUILT DRAWING


SCALE: 1/8" = 1'-0"	DATE: 10/21/20	DRAWN: RGE	APPROVED: RGE
PROJECT NO: Prop.Tours/a4b	SHEET NO: 6/7	PHASE: 1	

Notes:


1. ALL PLANS ARE CREATED BY REALTY 360° VIEW AND MADE EXCLUSIVELY FOR REAL ESTATE MARKETING PURPOSES.
2. SIZED AND DIMENSIONS ARE APPROXIMATE. ACTUAL MAY VARY.

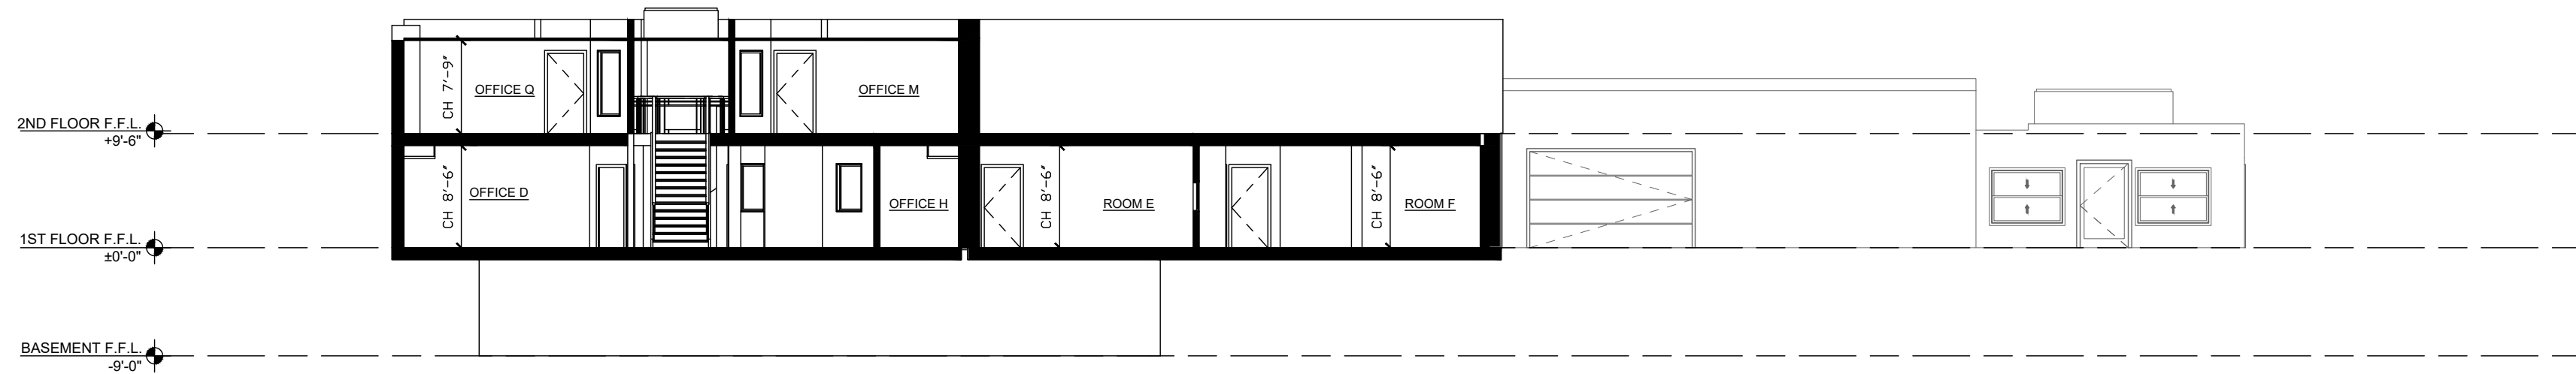

A CROSS SECTION A
7/7 SCALE: 1/12"=1'-0"

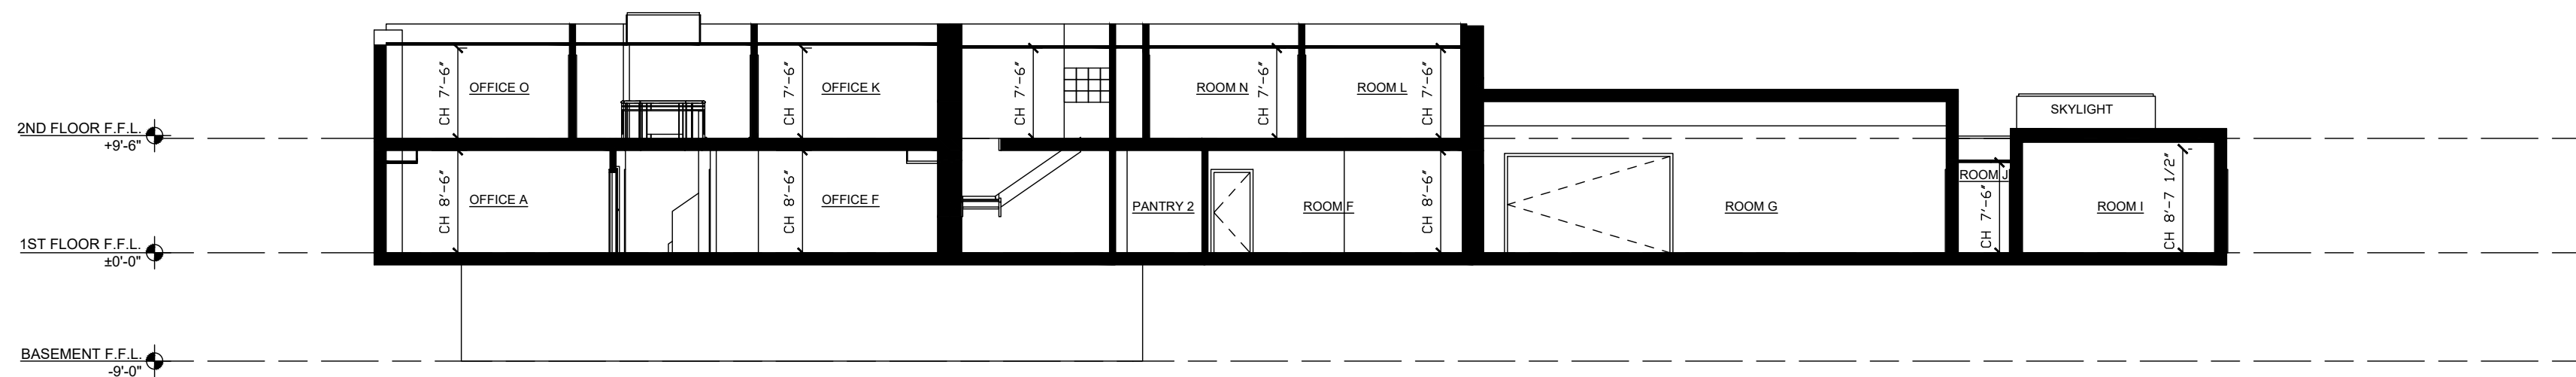

B CROSS SECTION B
7/7 SCALE: 1/12"=1'-0"

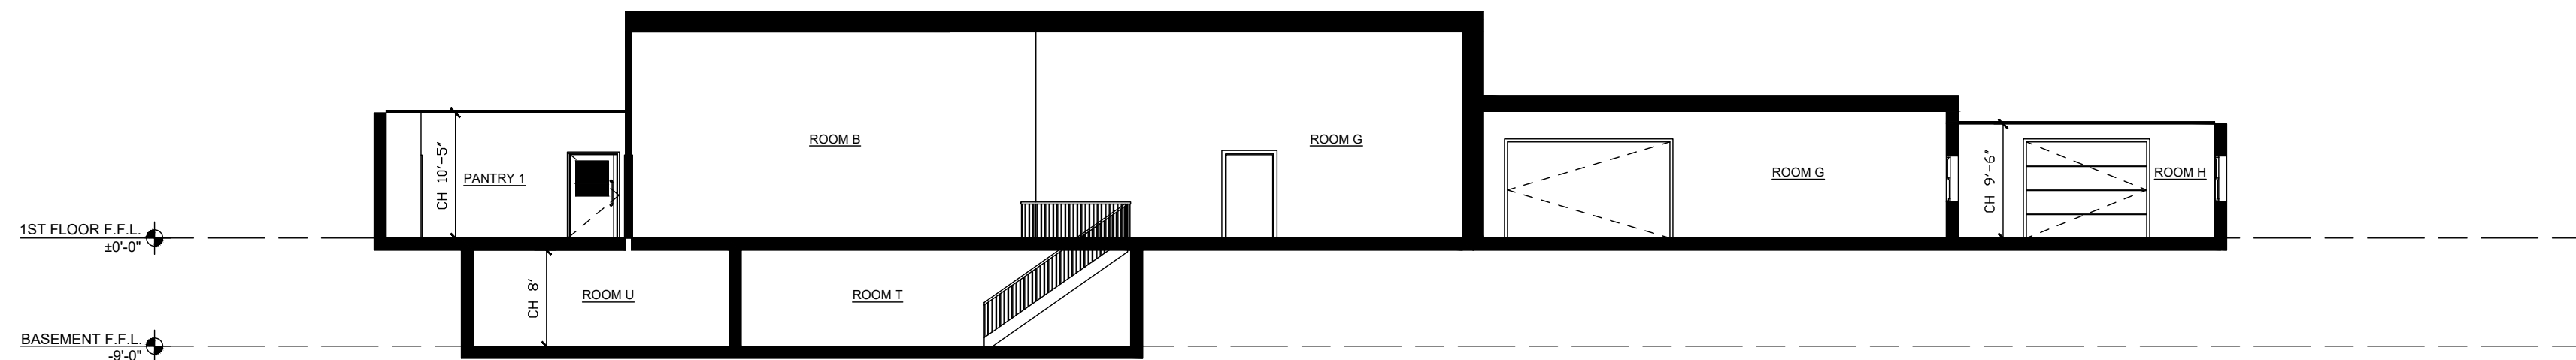

C CROSS SECTION C
7/7 SCALE: 1/12"=1'-0"

WALL LEGEND

	EXISTING WALL
--	---------------

ABBREVIATIONS

T.O.P	TOP OF PARAPET
B.O.J	BOTTOM OF JOIST
B.O.D	BOTTOM OF DUCT
B.O.D	BOTTOM OF DUCT
F.F.L	FINISH FLOOR LINE
N.G.L	NATURAL GRADE LINE
CH	CEILING HEIGHT

1	ISSUED FOR INFORMATION	RGE	10/21/20
REV:	DESCRIPTION:	BY:	DATE:

STATUS: **AS-BUILT**

REALTOR/BROKERAGE:

KYLE LUNDY
 Mobile: (970) 443-2900
 Office: (970) 225-5152
 Email: kylelundy@c3-re.com
<https://c3realestatesolutions.com/realtor/kyle-lundy/>



PRESENTED BY:

REALTY 360° VIEW
 Call or Text Us at: 720-770-1230
 Email Direct at: CR@Realty360View.com
 Website: <https://realty360view.com/>
 Address: 242 Linden St Fort Collins, CO 80524



SITE/LOCATION:
300-312 N Lincoln Ave Loveland, CO 80537

TITLE:
AS-BUILT DRAWING

SCALE: 1/12" = 1'-0"	DATE: 10/21/20	DRAWN: RGE	APPROVED: RGE
PROJECT NO: Prop.Tours/a4b	SHEET NO: 7/7	PHASE: 1	