

LOCATION MAP





STREET VIEW

Notes:

1. ALL PLANS ARE CREATED BY REALTY 360° VIEW AND MADE EXCLUSIVELY FOR REAL ESTATE MARKETING PURPOSES.
2. SIZED AND DIMENSIONS ARE APPROXIMATE. ACTUAL MAY VARY.


0	ISSUED FOR INFORMATION	RGE	10/11/20
REV:	DESCRIPTION:	BY:	DATE:
STATUS: AS-BUILT			
REALTOR/BROKERAGE:			
LUXE REALTY Mobile: - Office: (720) 575-1050 Email: admin@luxerealtydenver.com Web: https://luxerealtydenver.com/			
PRESENTED BY:			
REALTY 360° VIEW Call or Text Us at: 720-770-1230 Email Direct at: CR@Realty360View.com Website: https://realty360view.com/ Address: 242 Linden St Fort Collins, CO 80524			
SITE/:			
671 Elati St, Denver, CO 80204, USA			
TITLE:			
AS-BUILT DRAWING			
SCALE:	DATE:	DRAWN:	APPROVED:
NTS	10/11/20	RGE	
PROJECT NO:	SHEET NO:	PHASE:	
Prop.Tours/htb	1/6	2	

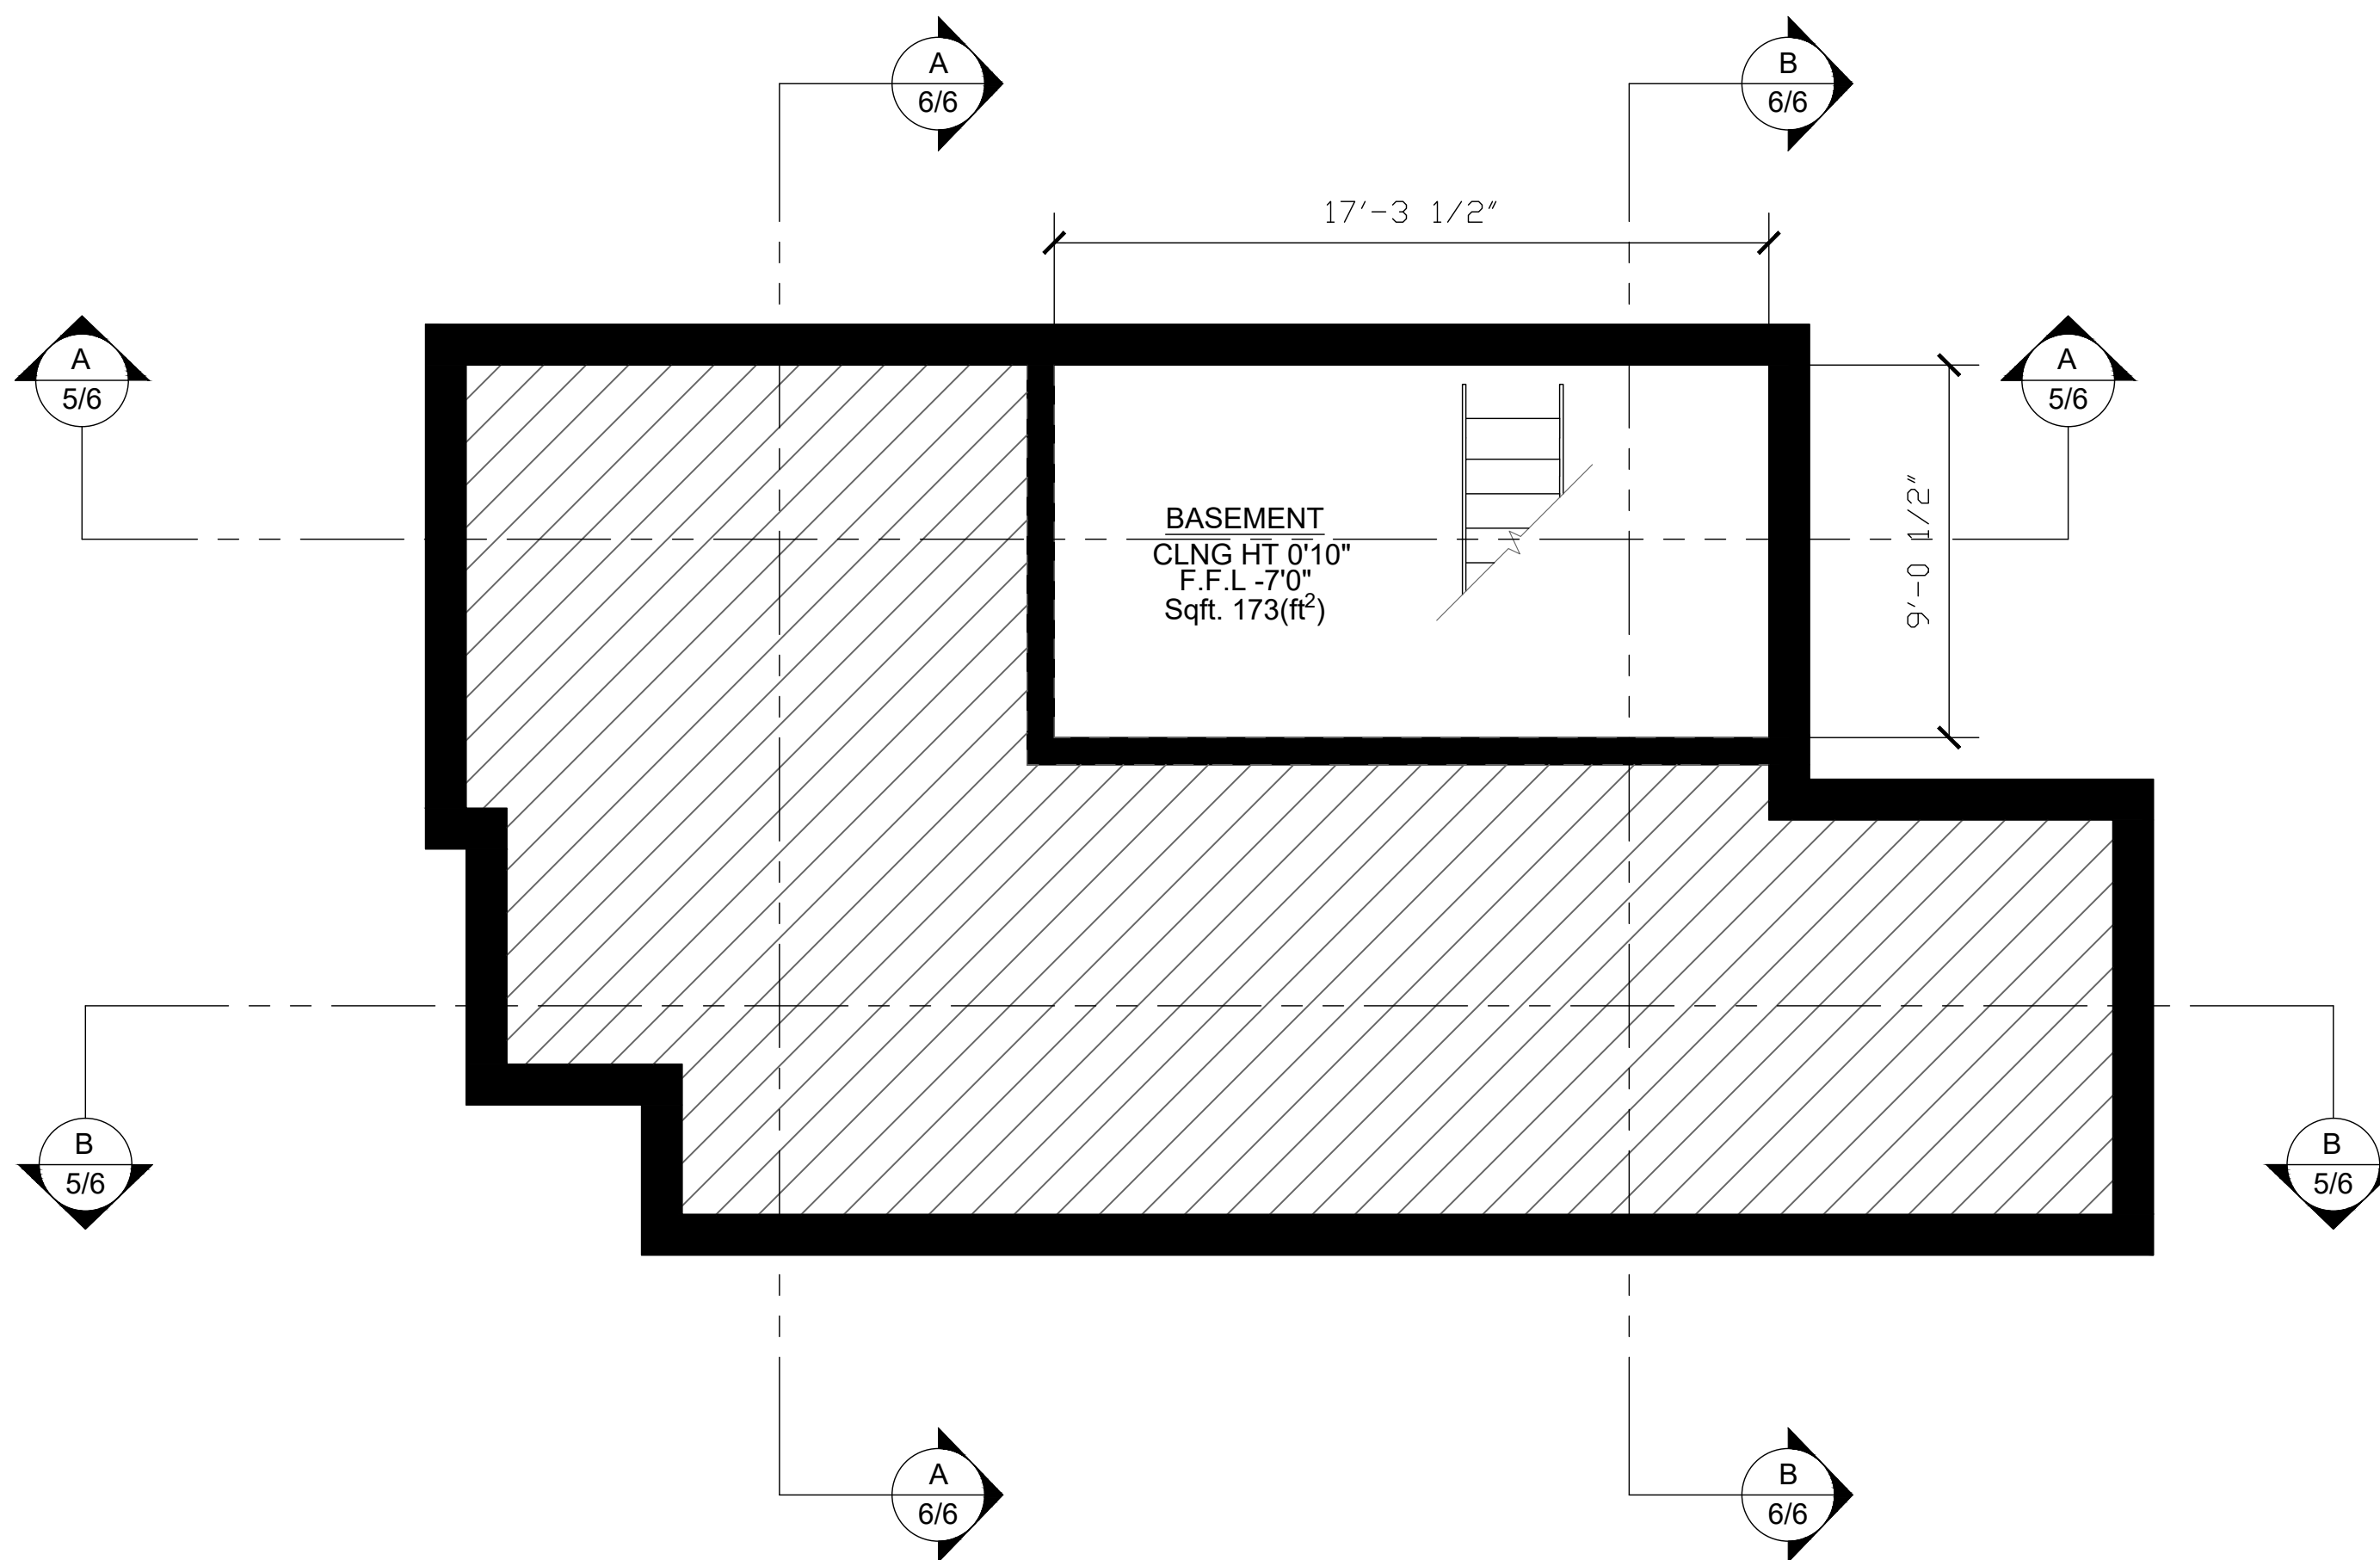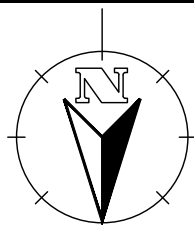

A BASEMENT FLOOR PLAN
2/6 SCALE: 1/4"=1'-0"

Notes:

- 1. ALL PLANS ARE CREATED BY REALTY 360° VIEW AND MADE EXCLUSIVELY FOR REAL ESTATE MARKETING PURPOSES.
- 2. SIZED AND DIMENSIONS ARE APPROXIMATE. ACTUAL MAY VARY.

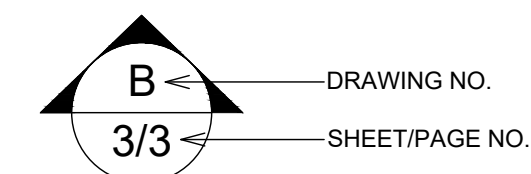

WALL LEGEND

EXISTING WALL

ABBREVIATIONS

T.O.P	TOP OF PARAPET
B.O.J	BOTTOM OF JOIST
B.O.D	BOTTOM OF DUCT
B.O.D	BOTTOM OF DUCT
F.F.L	FINISH FLOOR LINE
N.G.L	NATURAL GRADE LINE
CH	CEILING HEIGHT

0	ISSUED FOR INFORMATION	RGE	10/11/20
REV:	DESCRIPTION:	BY:	DATE:

STATUS: **AS-BUILT**

REALTOR/BROKERAGE:

LUXE REALTY
 Mobile: -
 Office: (720) 575-1050
 Email: admin@luxerealtydenver.com
 Web: https://luxerealtydenver.com/



PRESENTED BY:


REALTY 360° VIEW
 Call or Text Us at: 720-770-1230
 Email Direct at: CR@Realty360View.com
 Website: https://realty360view.com/
 Address: 242 Linden St Fort Collins, CO 80524



SITE: 671 Elati St, Denver, CO 80204, USA


TITLE: AS-BUILT DRAWING

SCALE: 1/4" = 1'-0"	DATE: 10/11/20	DRAWN: RGE	APPROVED:
PROJECT NO: Prop.Tours/htb	SHEET NO: 2/6	PHASE: 2	

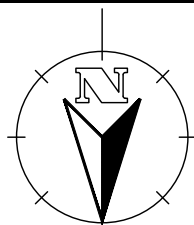

Notes:

1. ALL PLANS ARE CREATED BY REALTY 360° VIEW AND MADE EXCLUSIVELY FOR REAL ESTATE MARKETING PURPOSES.
2. SIZED AND DIMENSIONS ARE APPROXIMATE. ACTUAL MAY VARY.

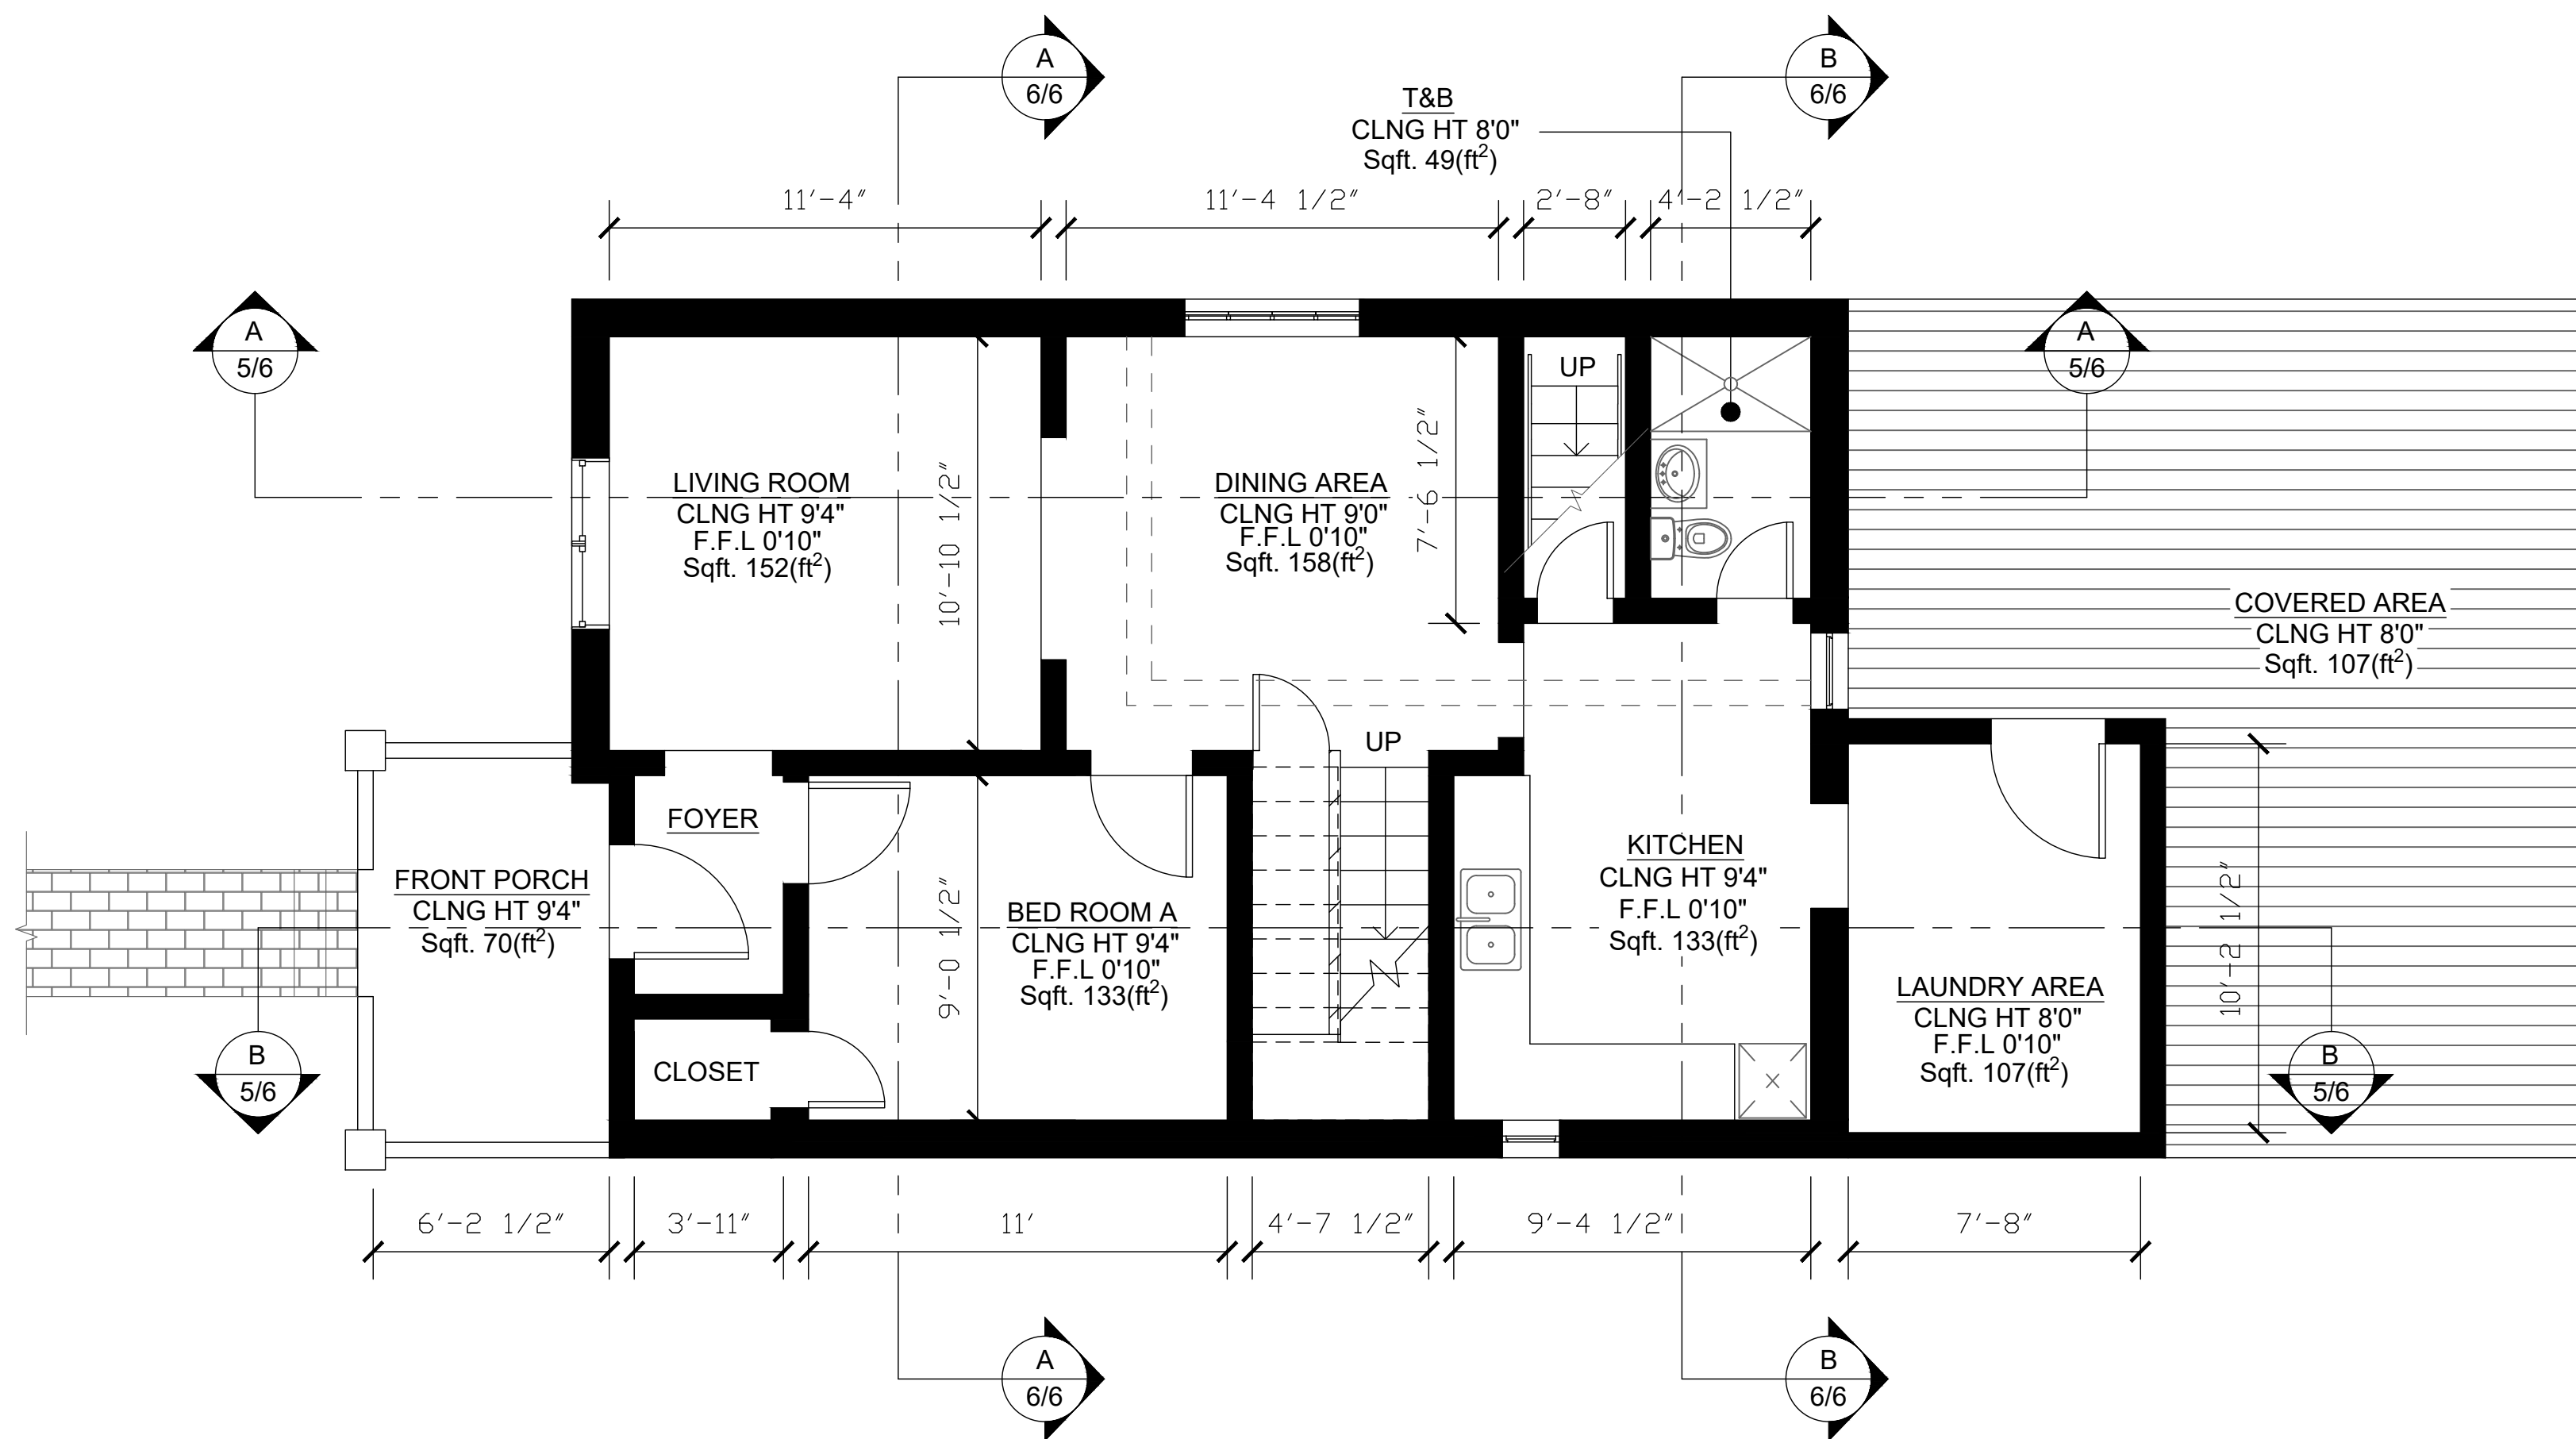

A FIRST FLOOR PLAN
3/6 SCALE: 1/4"=1'-0"

WALL LEGEND

	EXISTING WALL
--	---------------

ABBREVIATIONS

T.O.P	TOP OF PARAPET
B.O.J	BOTTOM OF JOIST
B.O.D	BOTTOM OF DUCT
B.O.D	BOTTOM OF DUCT
F.F.L	FINISH FLOOR LINE
N.G.L	NATURAL GRADE LINE
CH	CEILING HEIGHT

0	ISSUED FOR INFORMATION	RGE	10/11/20
---	------------------------	-----	----------

REV:	DESCRIPTION:	BY:	DATE:
------	--------------	-----	-------

STATUS: **AS-BUILT**

REALTOR/BROKERAGE:

LUXE REALTY
 Mobile: -
 Office: (720) 575-1050
 Email: admin@luxerealtydenver.com
 Web: https://luxerealtydenver.com/



PRESENTED BY:



REALTY 360° VIEW
 Call or Text Us at: 720-770-1230
 Email Direct at: CR@Realty360View.com
 Website: https://realty360view.com/
 Address: 242 Linden St Fort Collins, CO 80524



SITE: 671 Elati St, Denver, CO 80204, USA

TITLE: **AS-BUILT DRAWING**

SCALE: 1/4" = 1'-0"	DATE: 10/11/20	DRAWN: RGE	APPROVED:
PROJECT NO: Prop.Tours/htb	SHEET NO: 3/6	PHASE: 2	

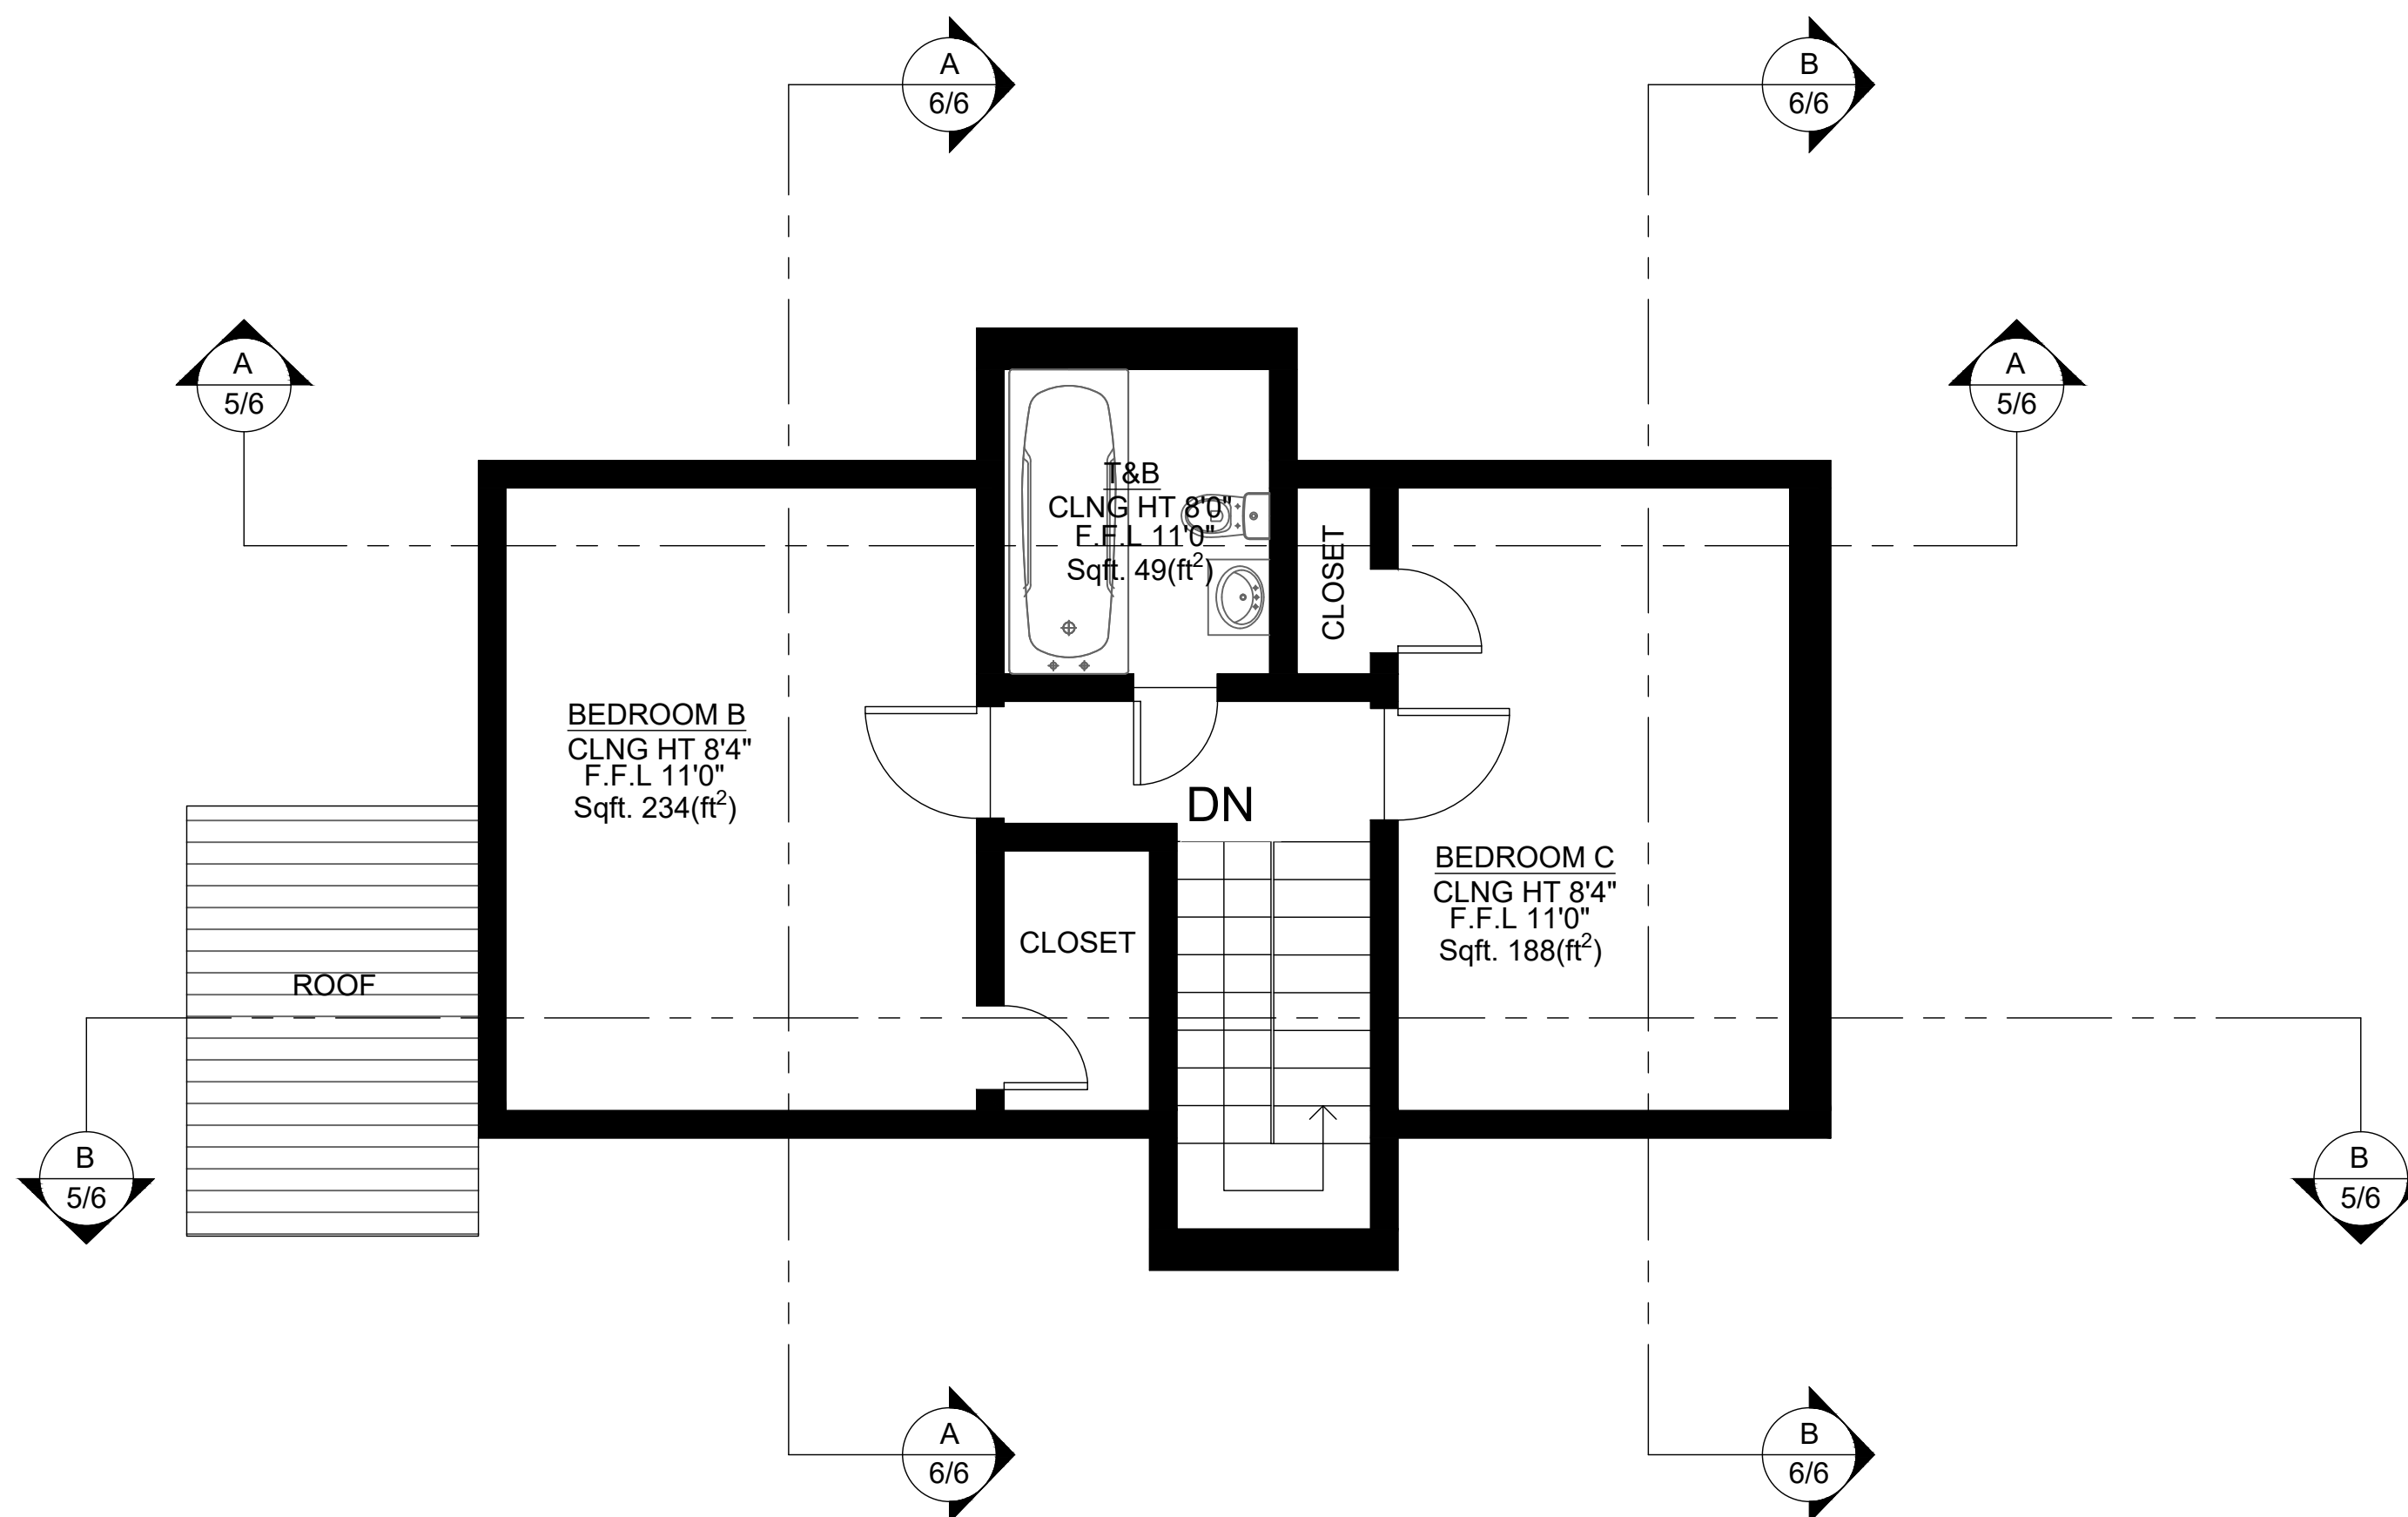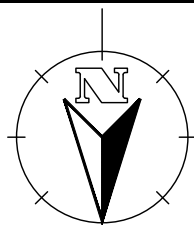

A SECOND FLOOR PLAN
4/6 SCALE: 1/4"=1'-0"

Notes:

1. ALL PLANS ARE CREATED BY REALTY 360° VIEW AND MADE EXCLUSIVELY FOR REAL ESTATE MARKETING PURPOSES.
2. SIZED AND DIMENSIONS ARE APPROXIMATE. ACTUAL MAY VARY.

WALL LEGEND

	EXISTING WALL
--	---------------

ABBREVIATIONS

T.O.P	TOP OF PARAPET
B.O.J	BOTTOM OF JOIST
B.O.D	BOTTOM OF DUCT
B.O.D	BOTTOM OF DUCT
F.F.L	FINISH FLOOR LINE
N.G.L	NATURAL GRADE LINE
CH	CEILING HEIGHT

0	ISSUED FOR INFORMATION	RGE	10/11/20
---	------------------------	-----	----------

REV:	DESCRIPTION:	BY:	DATE:
------	--------------	-----	-------

STATUS: **AS-BUILT**

REALTOR/BROKERAGE:
LUXE REALTY
 Mobile: -
 Office: (720) 575-1050
 Email: admin@luxerealtydenver.com
 Web: https://luxerealtydenver.com/



PRESENTED BY:
REALTY 360° VIEW
 Call or Text Us at: 720-770-1230
 Email Direct at: CR@Realty360View.com
 Website: https://realty360view.com/
 Address: 242 Linden St Fort Collins, CO 80524




SITE/:
671 Elati St, Denver, CO 80204, USA

TITLE:
AS-BUILT DRAWING

SCALE: 1/4" = 1'-0"	DATE: 10/11/20	DRAWN: RGE	APPROVED:
PROJECT NO: Prop.Tours/htb	SHEET NO: 4/6	PHASE: 2	



A LONGTITUDINAL SECTION A
 5/6 SCALE: 1/4"=1'-0"

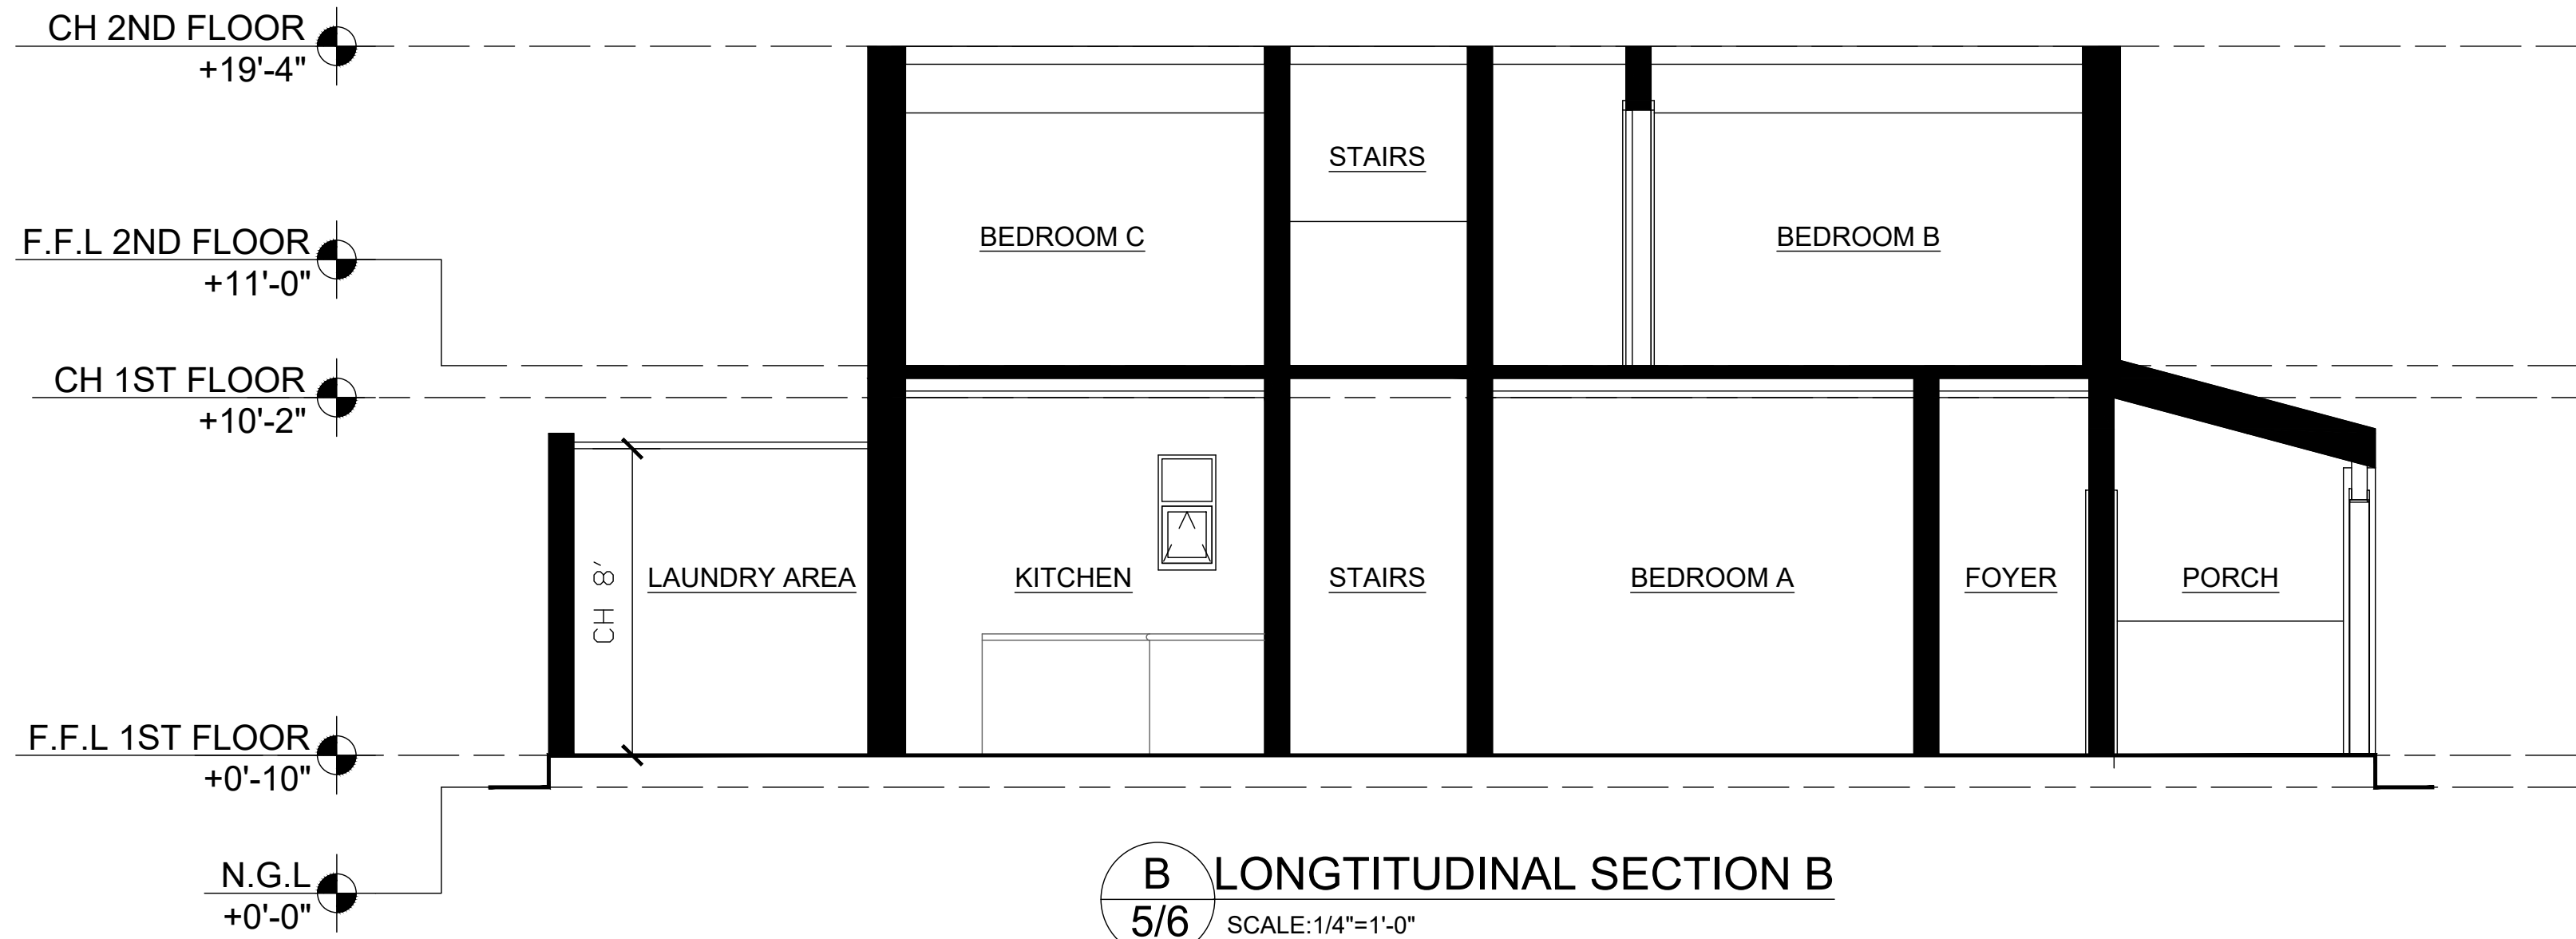

B LONGTITUDINAL SECTION B
 5/6 SCALE: 1/4"=1'-0"

Notes:

- 1. ALL PLANS ARE CREATED BY REALTY 360° VIEW AND MADE EXCLUSIVELY FOR REAL ESTATE MARKETING PURPOSES.
- 2. SIZED AND DIMENSIONS ARE APPROXIMATE. ACTUAL MAY VARY.

WALL LEGEND

	EXISTING WALL
--	---------------

ABBREVIATIONS

T.O.P	TOP OF PARAPET
B.O.J	BOTTOM OF JOIST
B.O.D	BOTTOM OF DUCT
B.O.D	BOTTOM OF DUCT
F.F.L	FINISH FLOOR LINE
N.G.L	NATURAL GRADE LINE
CH	CEILING HEIGHT

0	ISSUED FOR INFORMATION	RGE	10/11/20
REV:	DESCRIPTION:	BY:	DATE:

STATUS: **AS-BUILT**

REALTOR/BROKERAGE:

LUXE REALTY
 Mobile: -
 Office: (720) 575-1050
 Email: admin@luxerealtydenver.com
 Web: https://luxerealtydenver.com/



PRESENTED BY:


REALTY 360° VIEW
 Call or Text Us at: 720-770-1230
 Email Direct at: CR@Realty360View.com
 Website: https://realty360view.com/
 Address: 242 Linden St Fort Collins, CO 80524



SITE/:
 671 Elati St, Denver, CO 80204, USA

TITLE:
 AS-BUILT DRAWING

SCALE: 1/4" = 1'-0"	DATE: 10/11/20	DRAWN: RGE	APPROVED:
PROJECT NO: Prop.Tours/htb	SHEET NO: 5/6	PHASE: 2	

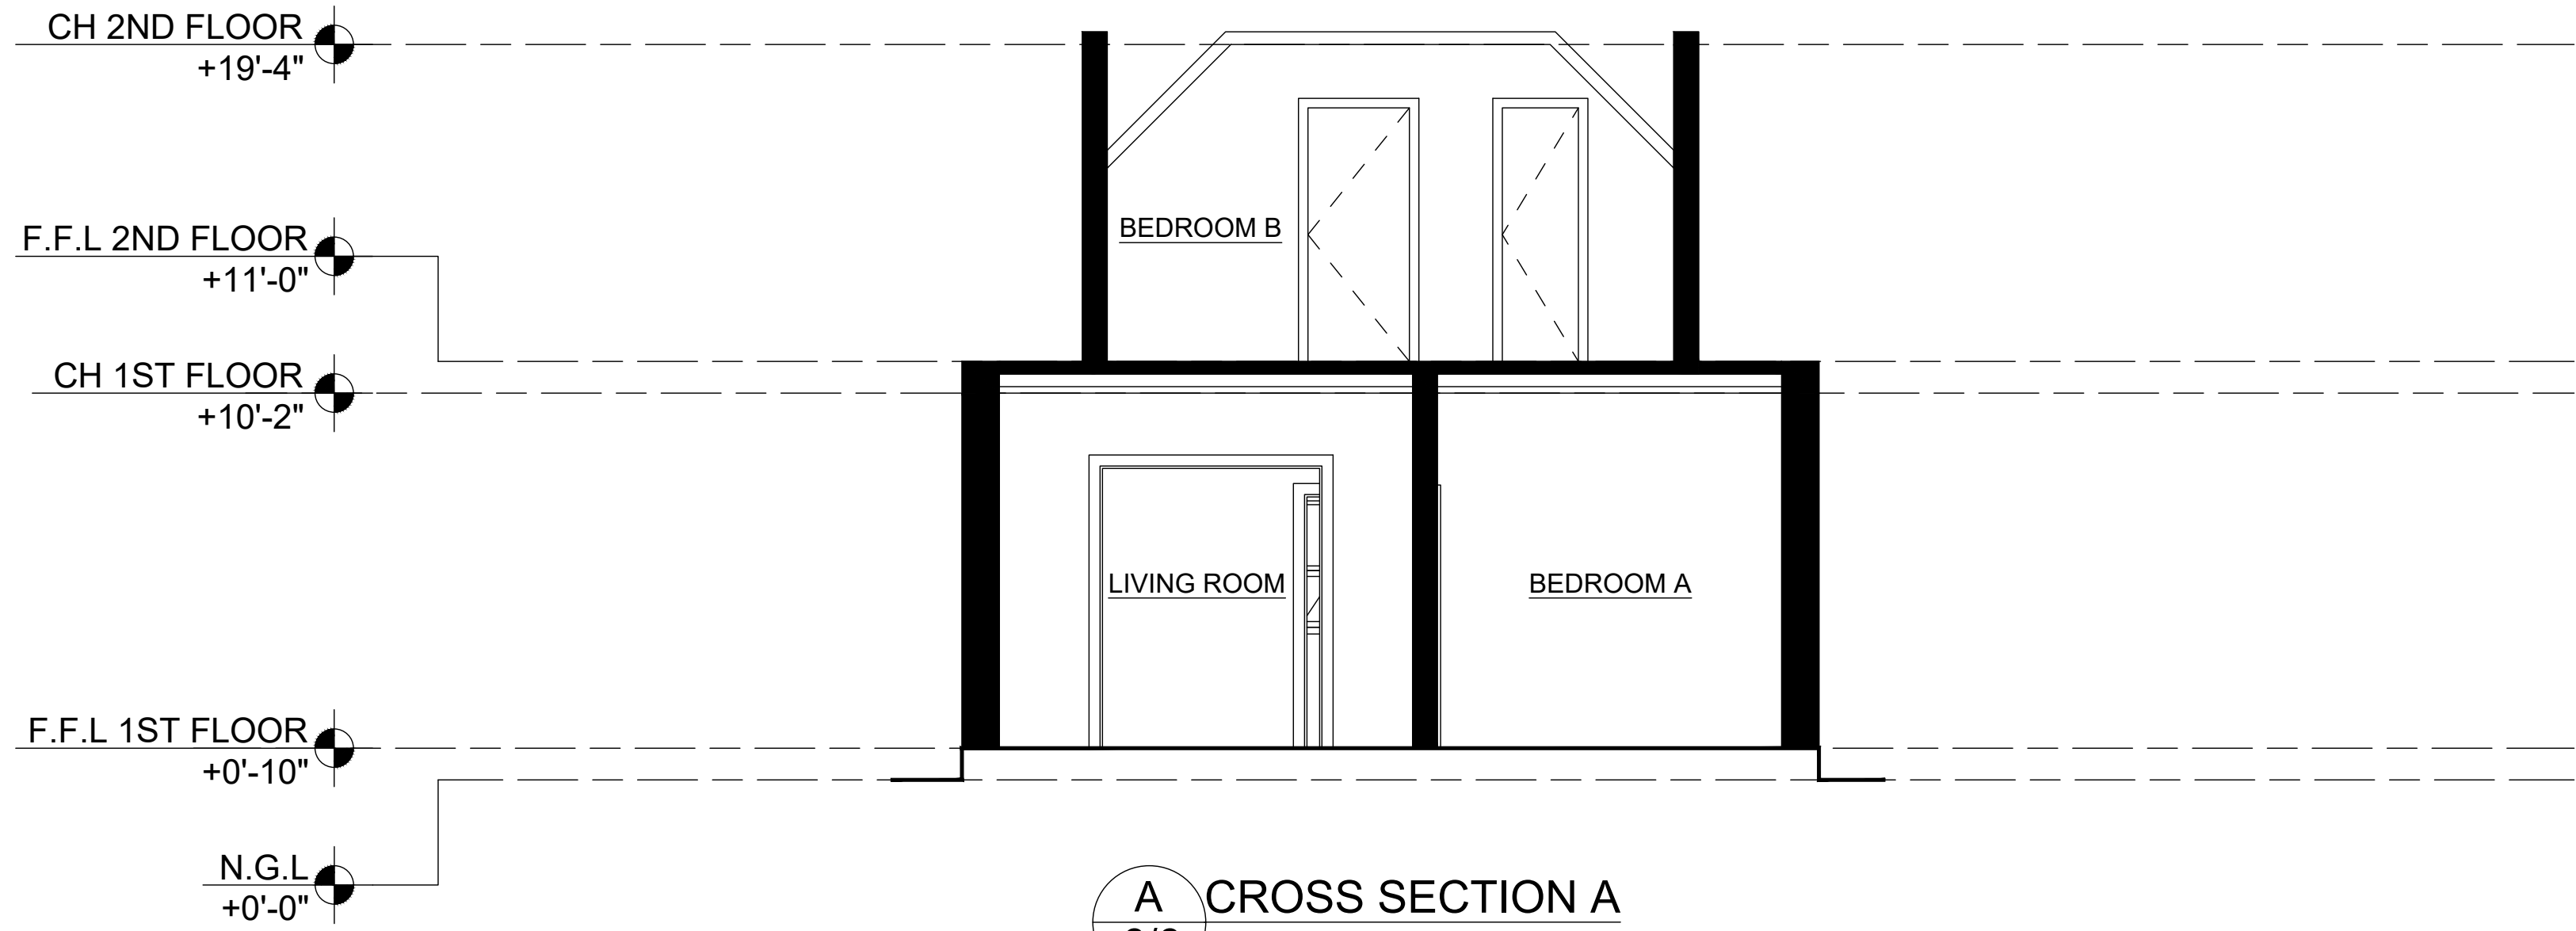

A CROSS SECTION A
6/6 SCALE: 1/4"=1'-0"



B CROSSL SECTION B
6/6 SCALE: 1/4"=1'-0"

Notes:

- 1. ALL PLANS ARE CREATED BY REALTY 360° VIEW AND MADE EXCLUSIVELY FOR REAL ESTATE MARKETING PURPOSES.
- 2. SIZED AND DIMENSIONS ARE APPROXIMATE. ACTUAL MAY VARY.

WALL LEGEND

	EXISTING WALL
--	---------------

ABBREVIATIONS

T.O.P	TOP OF PARAPET
B.O.J	BOTTOM OF JOIST
B.O.D	BOTTOM OF DUCT
B.O.D	BOTTOM OF DUCT
F.F.L	FINISH FLOOR LINE
N.G.L	NATURAL GRADE LINE
CH	CEILING HEIGHT

0	ISSUED FOR INFORMATION	RGE	10/11/20
REV:	DESCRIPTION:	BY:	DATE:

STATUS: **AS-BUILT**

REALTOR/BROKERAGE:

LUXE REALTY
 Mobile: -
 Office: (720) 575-1050
 Email: admin@luxerealtydenver.com
 Web: https://luxerealtydenver.com/



PRESENTED BY:

REALTY 360° VIEW
 Call or Text Us at: 720-770-1230
 Email Direct at: CR@Realty360View.com
 Website: https://realty360view.com/
 Address: 242 Linden St Fort Collins, CO 80524



SITE/: 671 Elati St, Denver, CO 80204, USA

TITLE: AS-BUILT DRAWING

SCALE: 1/4" = 1'-0"	DATE: 10/11/20	DRAWN: RGE	APPROVED:
PROJECT NO: Prop.Tours/htb	SHEET NO: 6/6	PHASE: 2	