

LOCATION MAP





STREET VIEW

Notes:

1. ALL PLANS ARE CREATED BY REALTY 360° VIEW AND MADE EXCLUSIVELY FOR REAL ESTATE MARKETING PURPOSES.
2. SIZED AND DIMENSIONS ARE APPROXIMATE. ACTUAL MAY VARY.


0	ISSUED FOR INFORMATION	RGE	10/11/20
REV:	DESCRIPTION:	BY:	DATE:
STATUS: AS-BUILT			
REALTOR/BROKERAGE:			
<b>LUXE REALTY</b> Mobile: - Office: (720) 575-1050 Email: admin@luxerealtydenver.com Web: https://luxerealtydenver.com/			
PRESENTED BY:			
<b>REALTY 360° VIEW</b> Call or Text Us at: 720-770-1230 Email Direct at: CR@Realty360View.com Website: https://realty360view.com/ Address: 242 Linden St Fort Collins, CO 80524			
SITE/:			
671 Elati St, Denver, CO 80204, USA			
TITLE:			
AS-BUILT DRAWING			
SCALE:	DATE:	DRAWN:	APPROVED:
NTS	10/11/20	RGE	
PROJECT NO:	SHEET NO:	PHASE:	
Prop.Tours/htb	1/6	0	

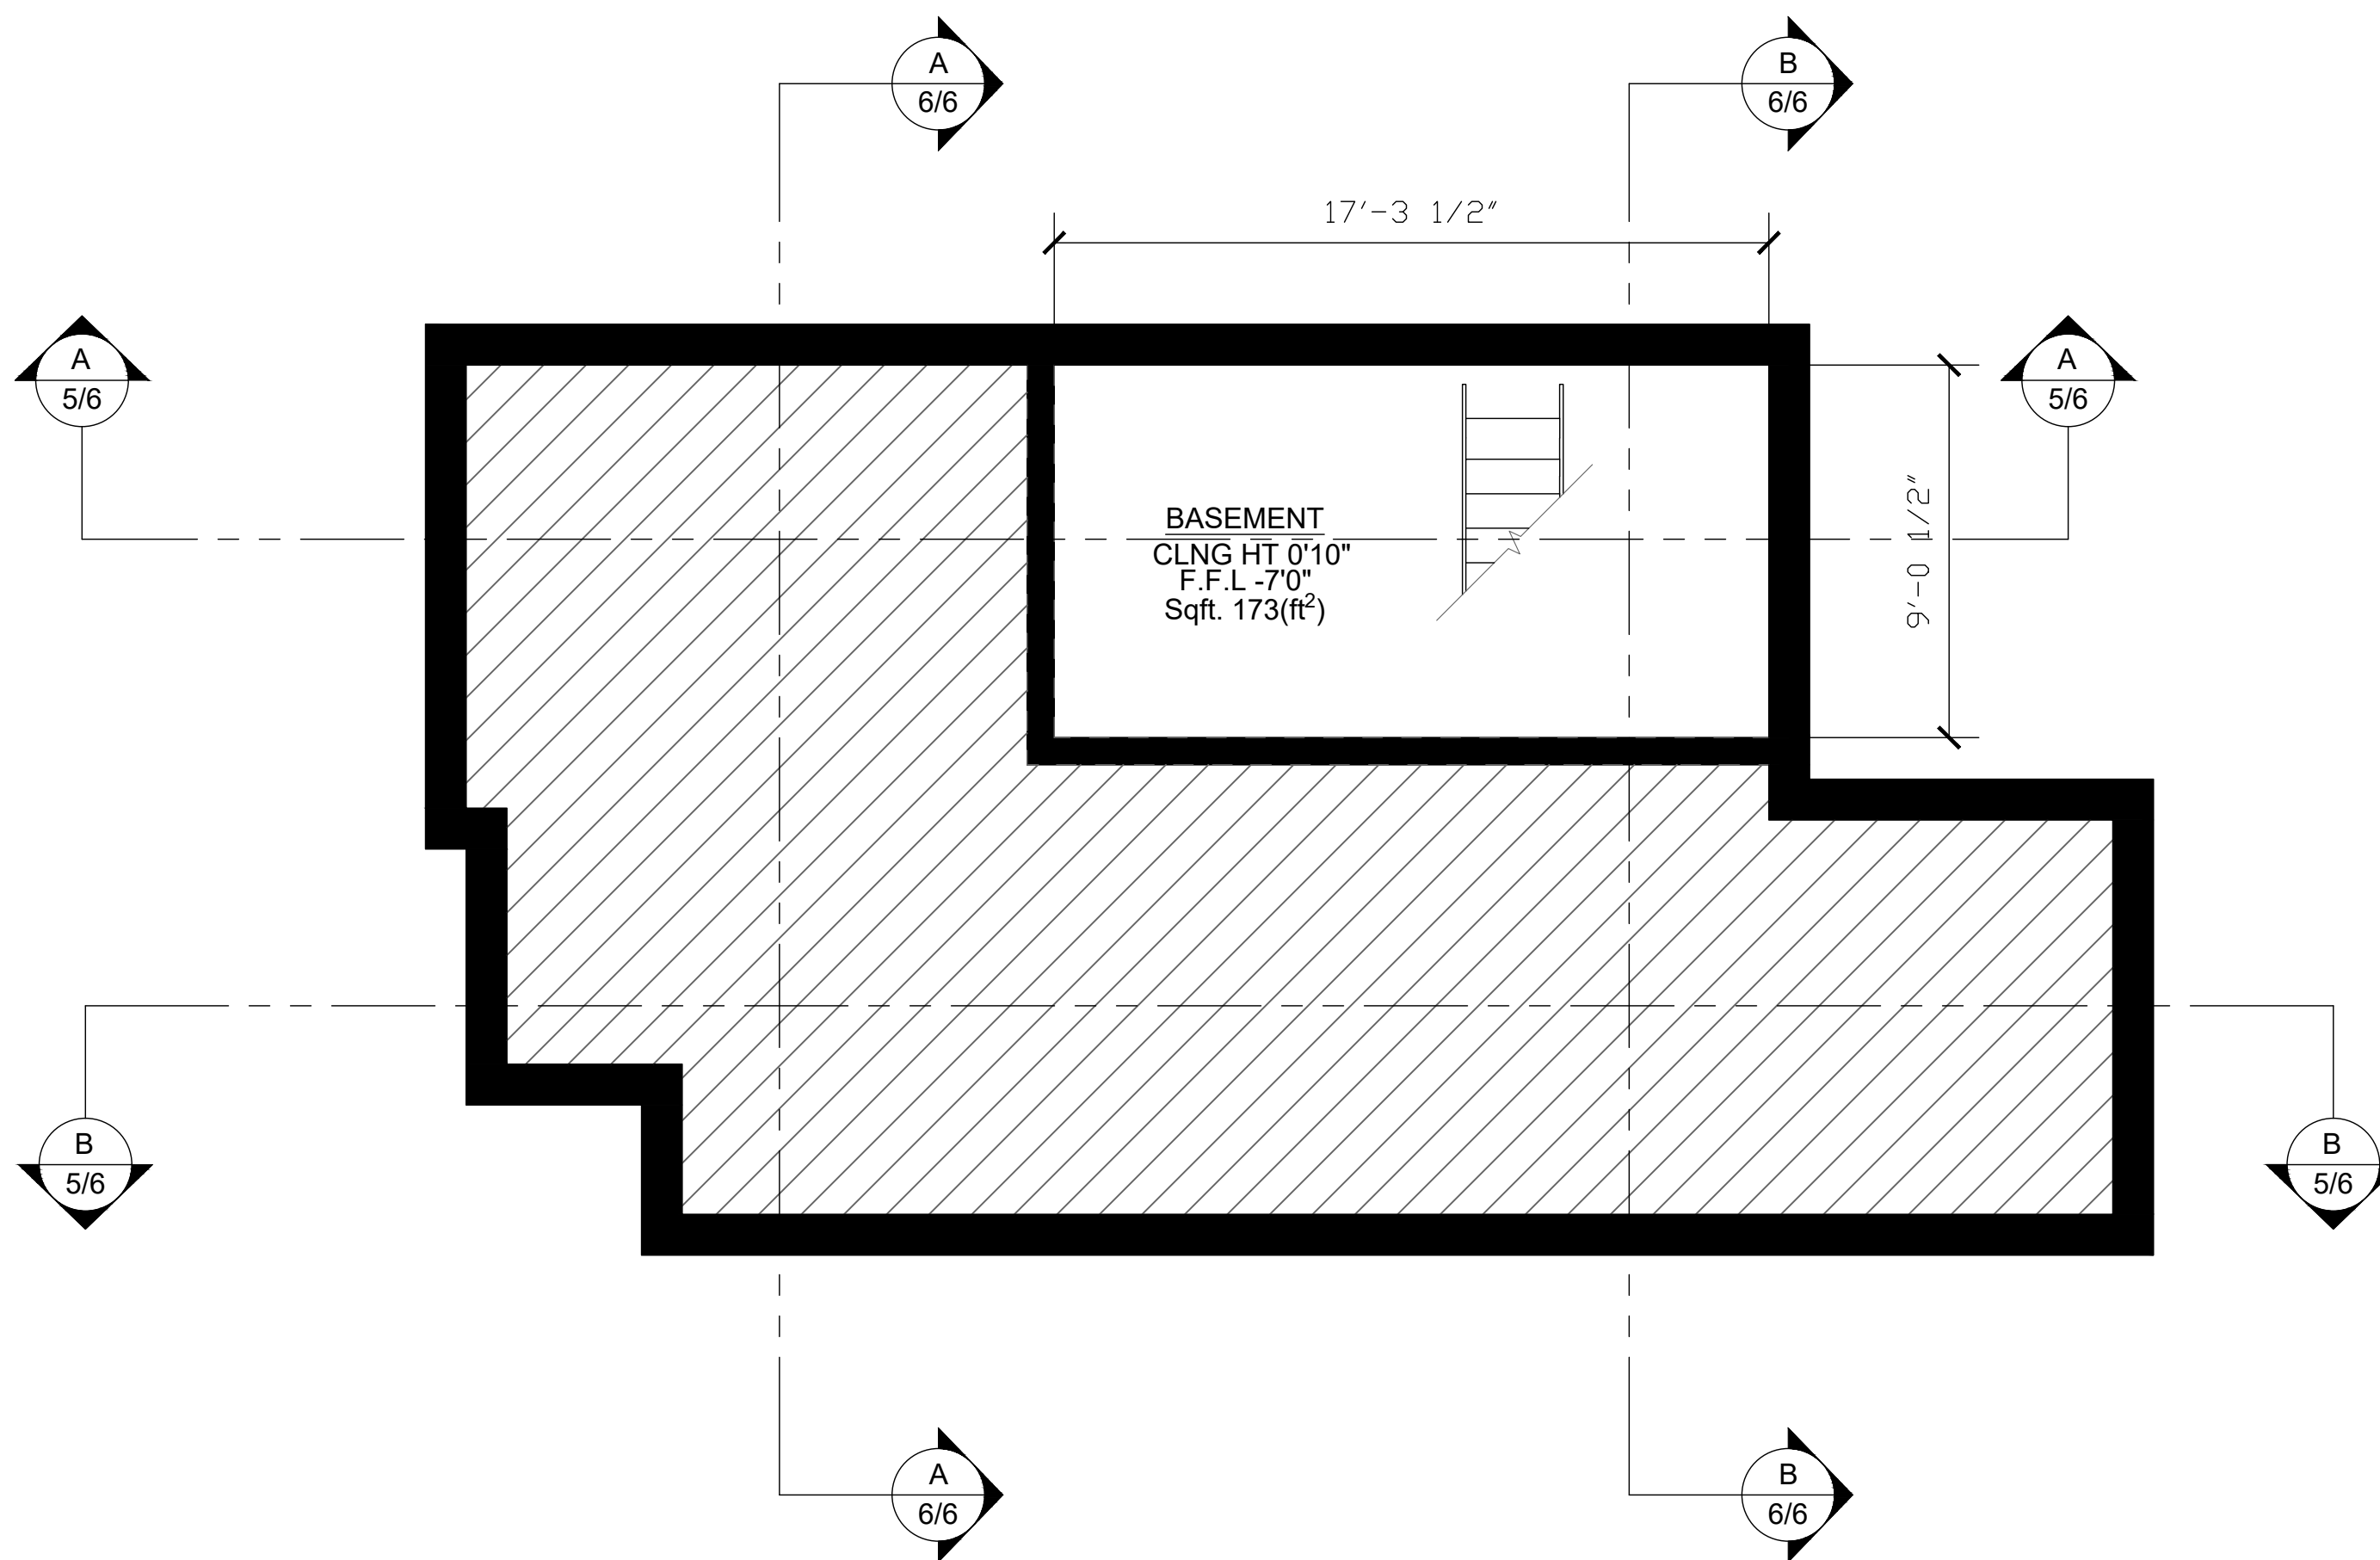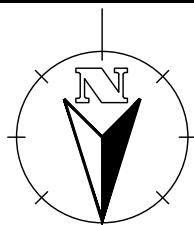

**A** **BASEMENT FLOOR PLAN**  
**2/6** SCALE: 1/4"=1'-0"

**Notes:**

1. ALL PLANS ARE CREATED BY REALTY 360° VIEW AND MADE EXCLUSIVELY FOR REAL ESTATE MARKETING PURPOSES.
2. SIZED AND DIMENSIONS ARE APPROXIMATE. ACTUAL MAY VARY.

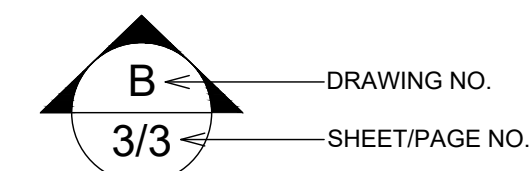

**WALL LEGEND**

EXISTING WALL

**ABBREVIATIONS**

T.O.P	TOP OF PARAPET
B.O.J	BOTTOM OF JOIST
B.O.D	BOTTOM OF DUCT
B.O.D	BOTTOM OF DUCT
F.F.L	FINISH FLOOR LINE
N.G.L	NATURAL GRADE LINE
CH	CEILING HEIGHT

0	ISSUED FOR INFORMATION	RGE	10/11/20
REV:	DESCRIPTION:	BY:	DATE:

STATUS: **AS-BUILT**

REALTOR/BROKERAGE:

**LUXE REALTY**  
 Mobile: -  
 Office: (720) 575-1050  
 Email: admin@luxerealtydenver.com  
 Web: https://luxerealtydenver.com/



PRESENTED BY:

**REALTY 360° VIEW**  
 Call or Text Us at: 720-770-1230  
 Email Direct at: CR@Realty360View.com  
 Website: https://realty360view.com/  
 Address: 242 Linden St Fort Collins, CO 80524




SITE: 671 Elati St, Denver, CO 80204, USA

TITLE: AS-BUILT DRAWING


SCALE: 1/4" = 1'-0"	DATE: 10/11/20	DRAWN: RGE	APPROVED:
PROJECT NO: Prop.Tours/htb	SHEET NO: 2/6	PHASE: 0	



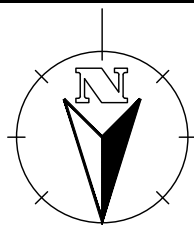

**Notes:**

1. ALL PLANS ARE CREATED BY REALTY 360° VIEW AND MADE EXCLUSIVELY FOR REAL ESTATE MARKETING PURPOSES.
2. SIZED AND DIMENSIONS ARE APPROXIMATE. ACTUAL MAY VARY.

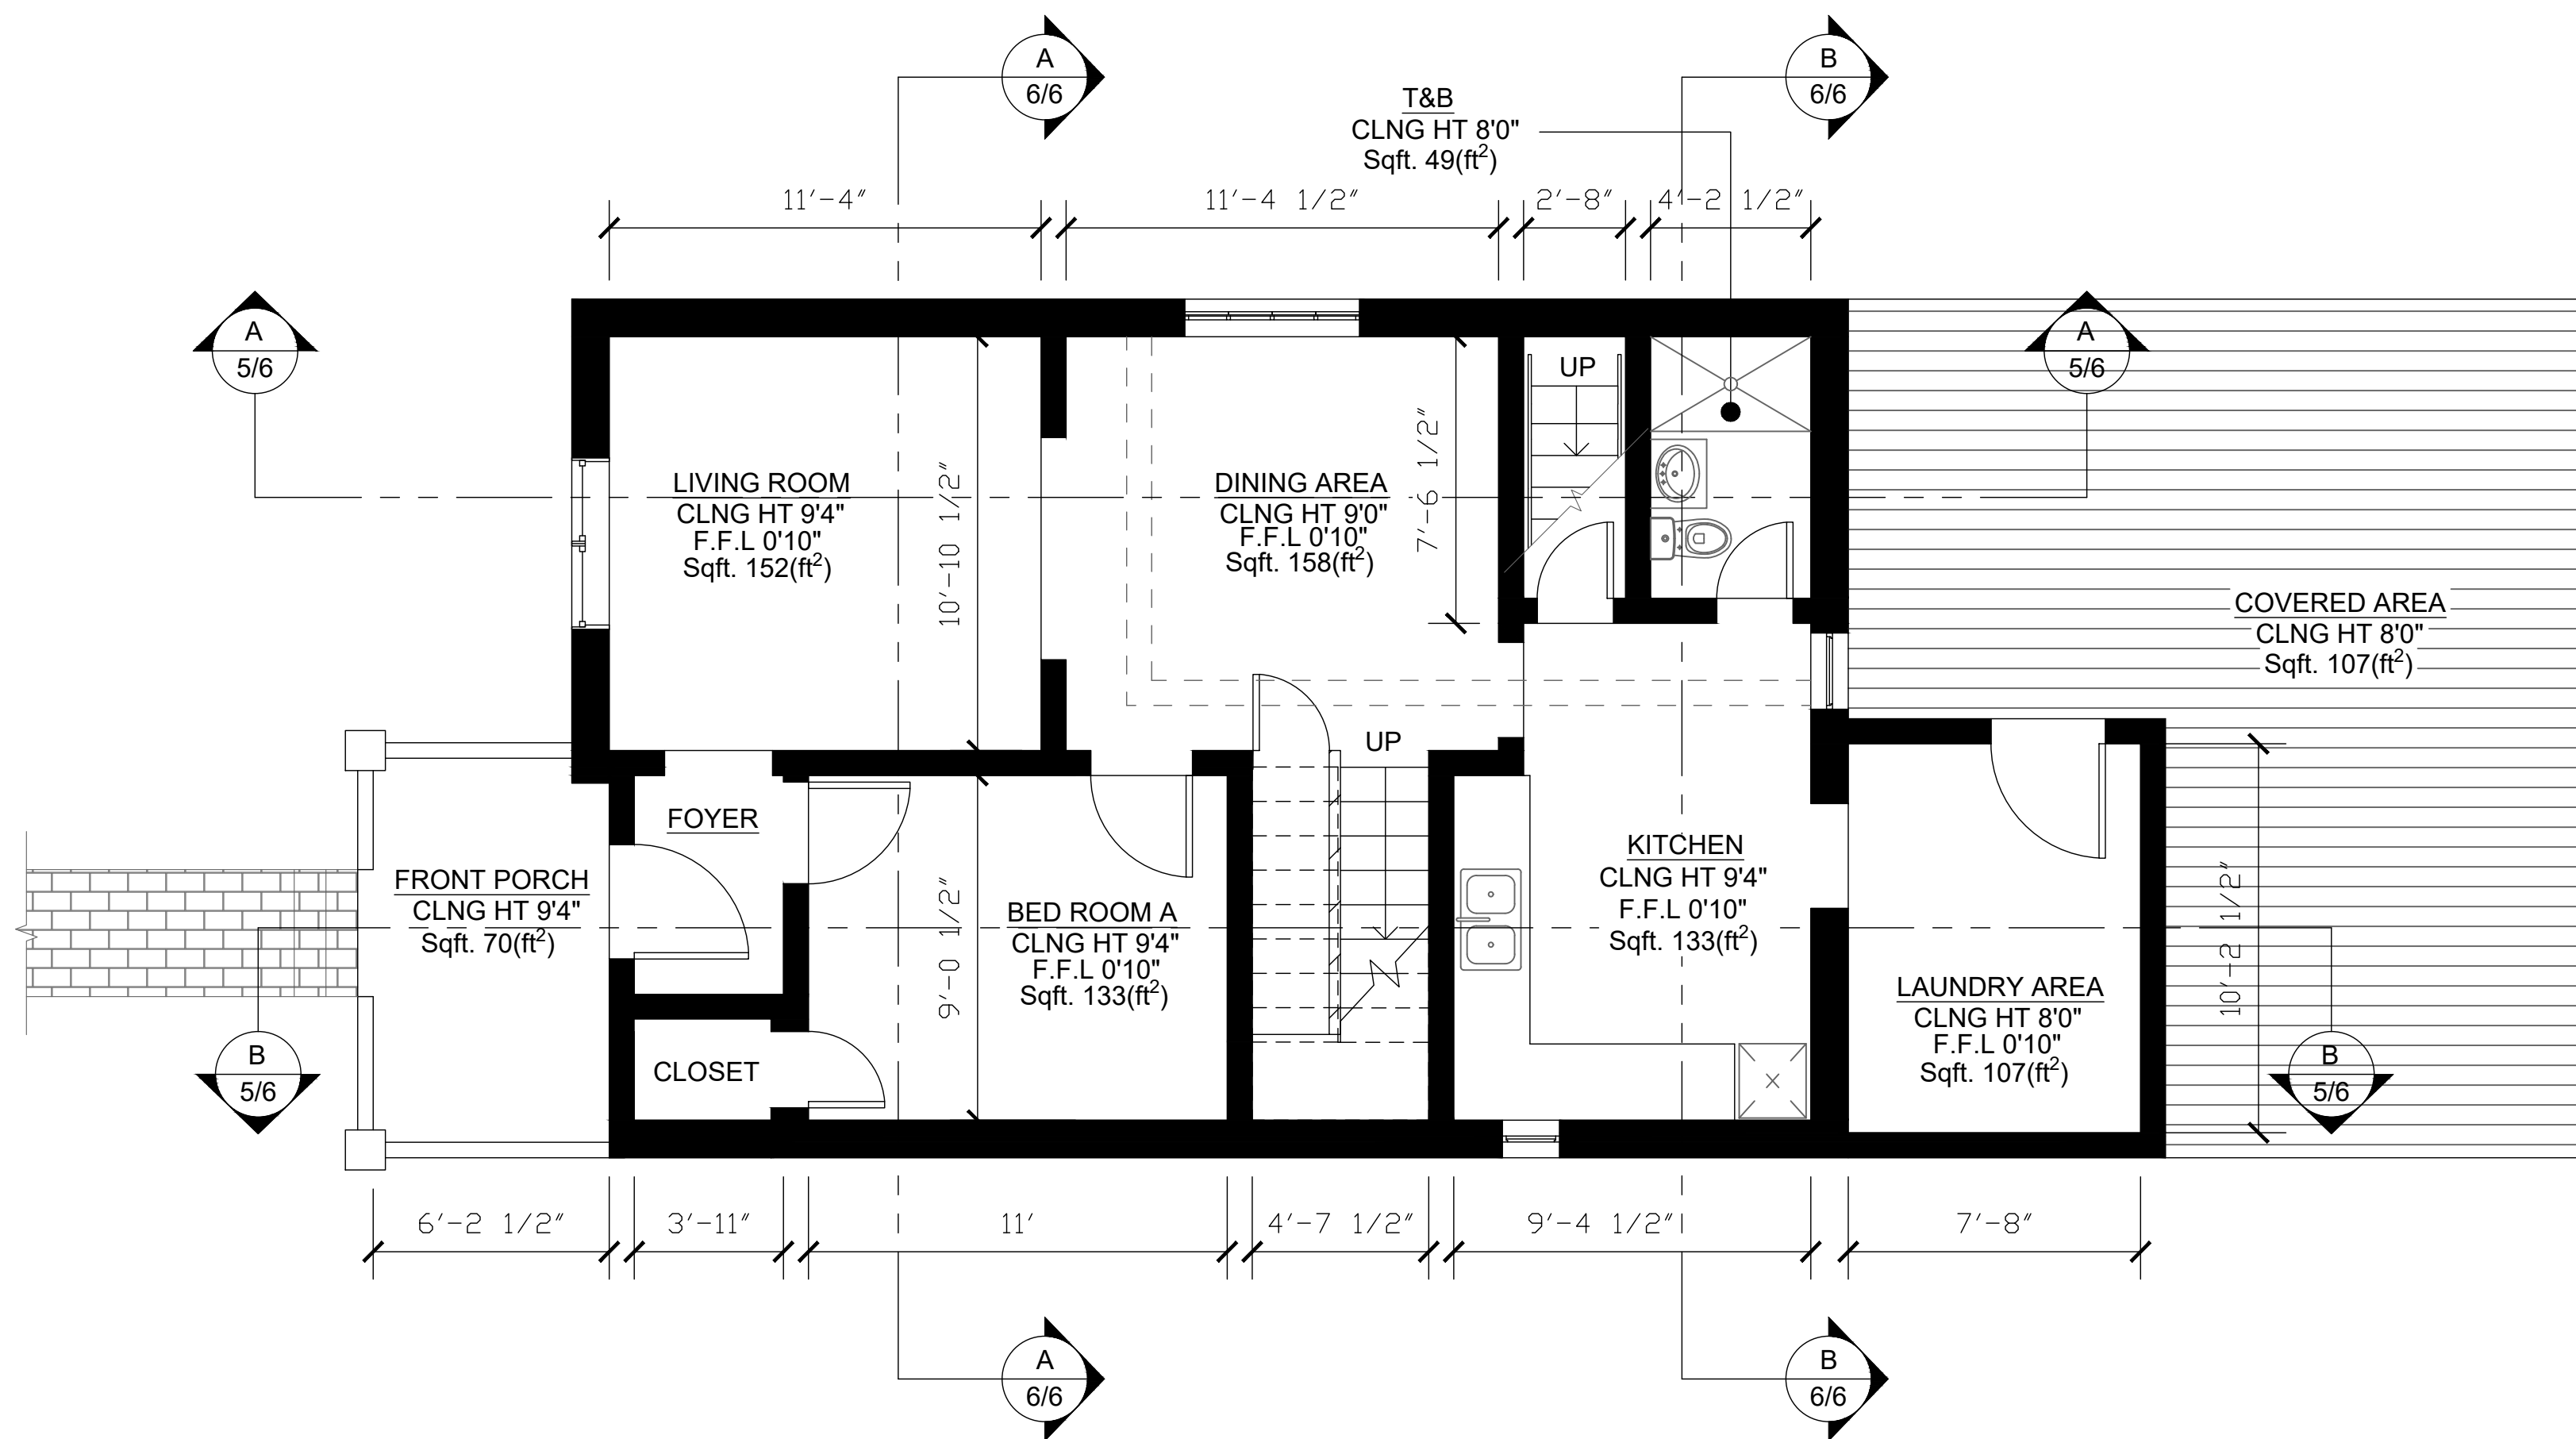

**A FIRST FLOOR PLAN**  
**3/6** SCALE: 1/4"=1'-0"

**WALL LEGEND**

	EXISTING WALL
--	---------------

**ABBREVIATIONS**

T.O.P	TOP OF PARAPET
B.O.J	BOTTOM OF JOIST
B.O.D	BOTTOM OF DUCT
B.O.D	BOTTOM OF DUCT
F.F.L	FINISH FLOOR LINE
N.G.L	NATURAL GRADE LINE
CH	CEILING HEIGHT

0	ISSUED FOR INFORMATION	RGE	10/11/20
---	------------------------	-----	----------

REV:	DESCRIPTION:	BY:	DATE:
------	--------------	-----	-------

STATUS: **AS-BUILT**

REALTOR/BROKERAGE:

**LUXE REALTY**  
 Mobile: -  
 Office: (720) 575-1050  
 Email: admin@luxerealtydenver.com  
 Web: https://luxerealtydenver.com/



PRESENTED BY:



**REALTY 360° VIEW**  
 Call or Text Us at: 720-770-1230  
 Email Direct at: CR@Realty360View.com  
 Website: https://realty360view.com/  
 Address: 242 Linden St Fort Collins, CO 80524



SITE: 671 Elati St, Denver, CO 80204, USA

TITLE: **AS-BUILT DRAWING**

SCALE: 1/4" = 1'-0"	DATE: 10/11/20	DRAWN: RGE	APPROVED:
PROJECT NO: Prop.Tours/htb	SHEET NO: 3/6	PHASE: 0	

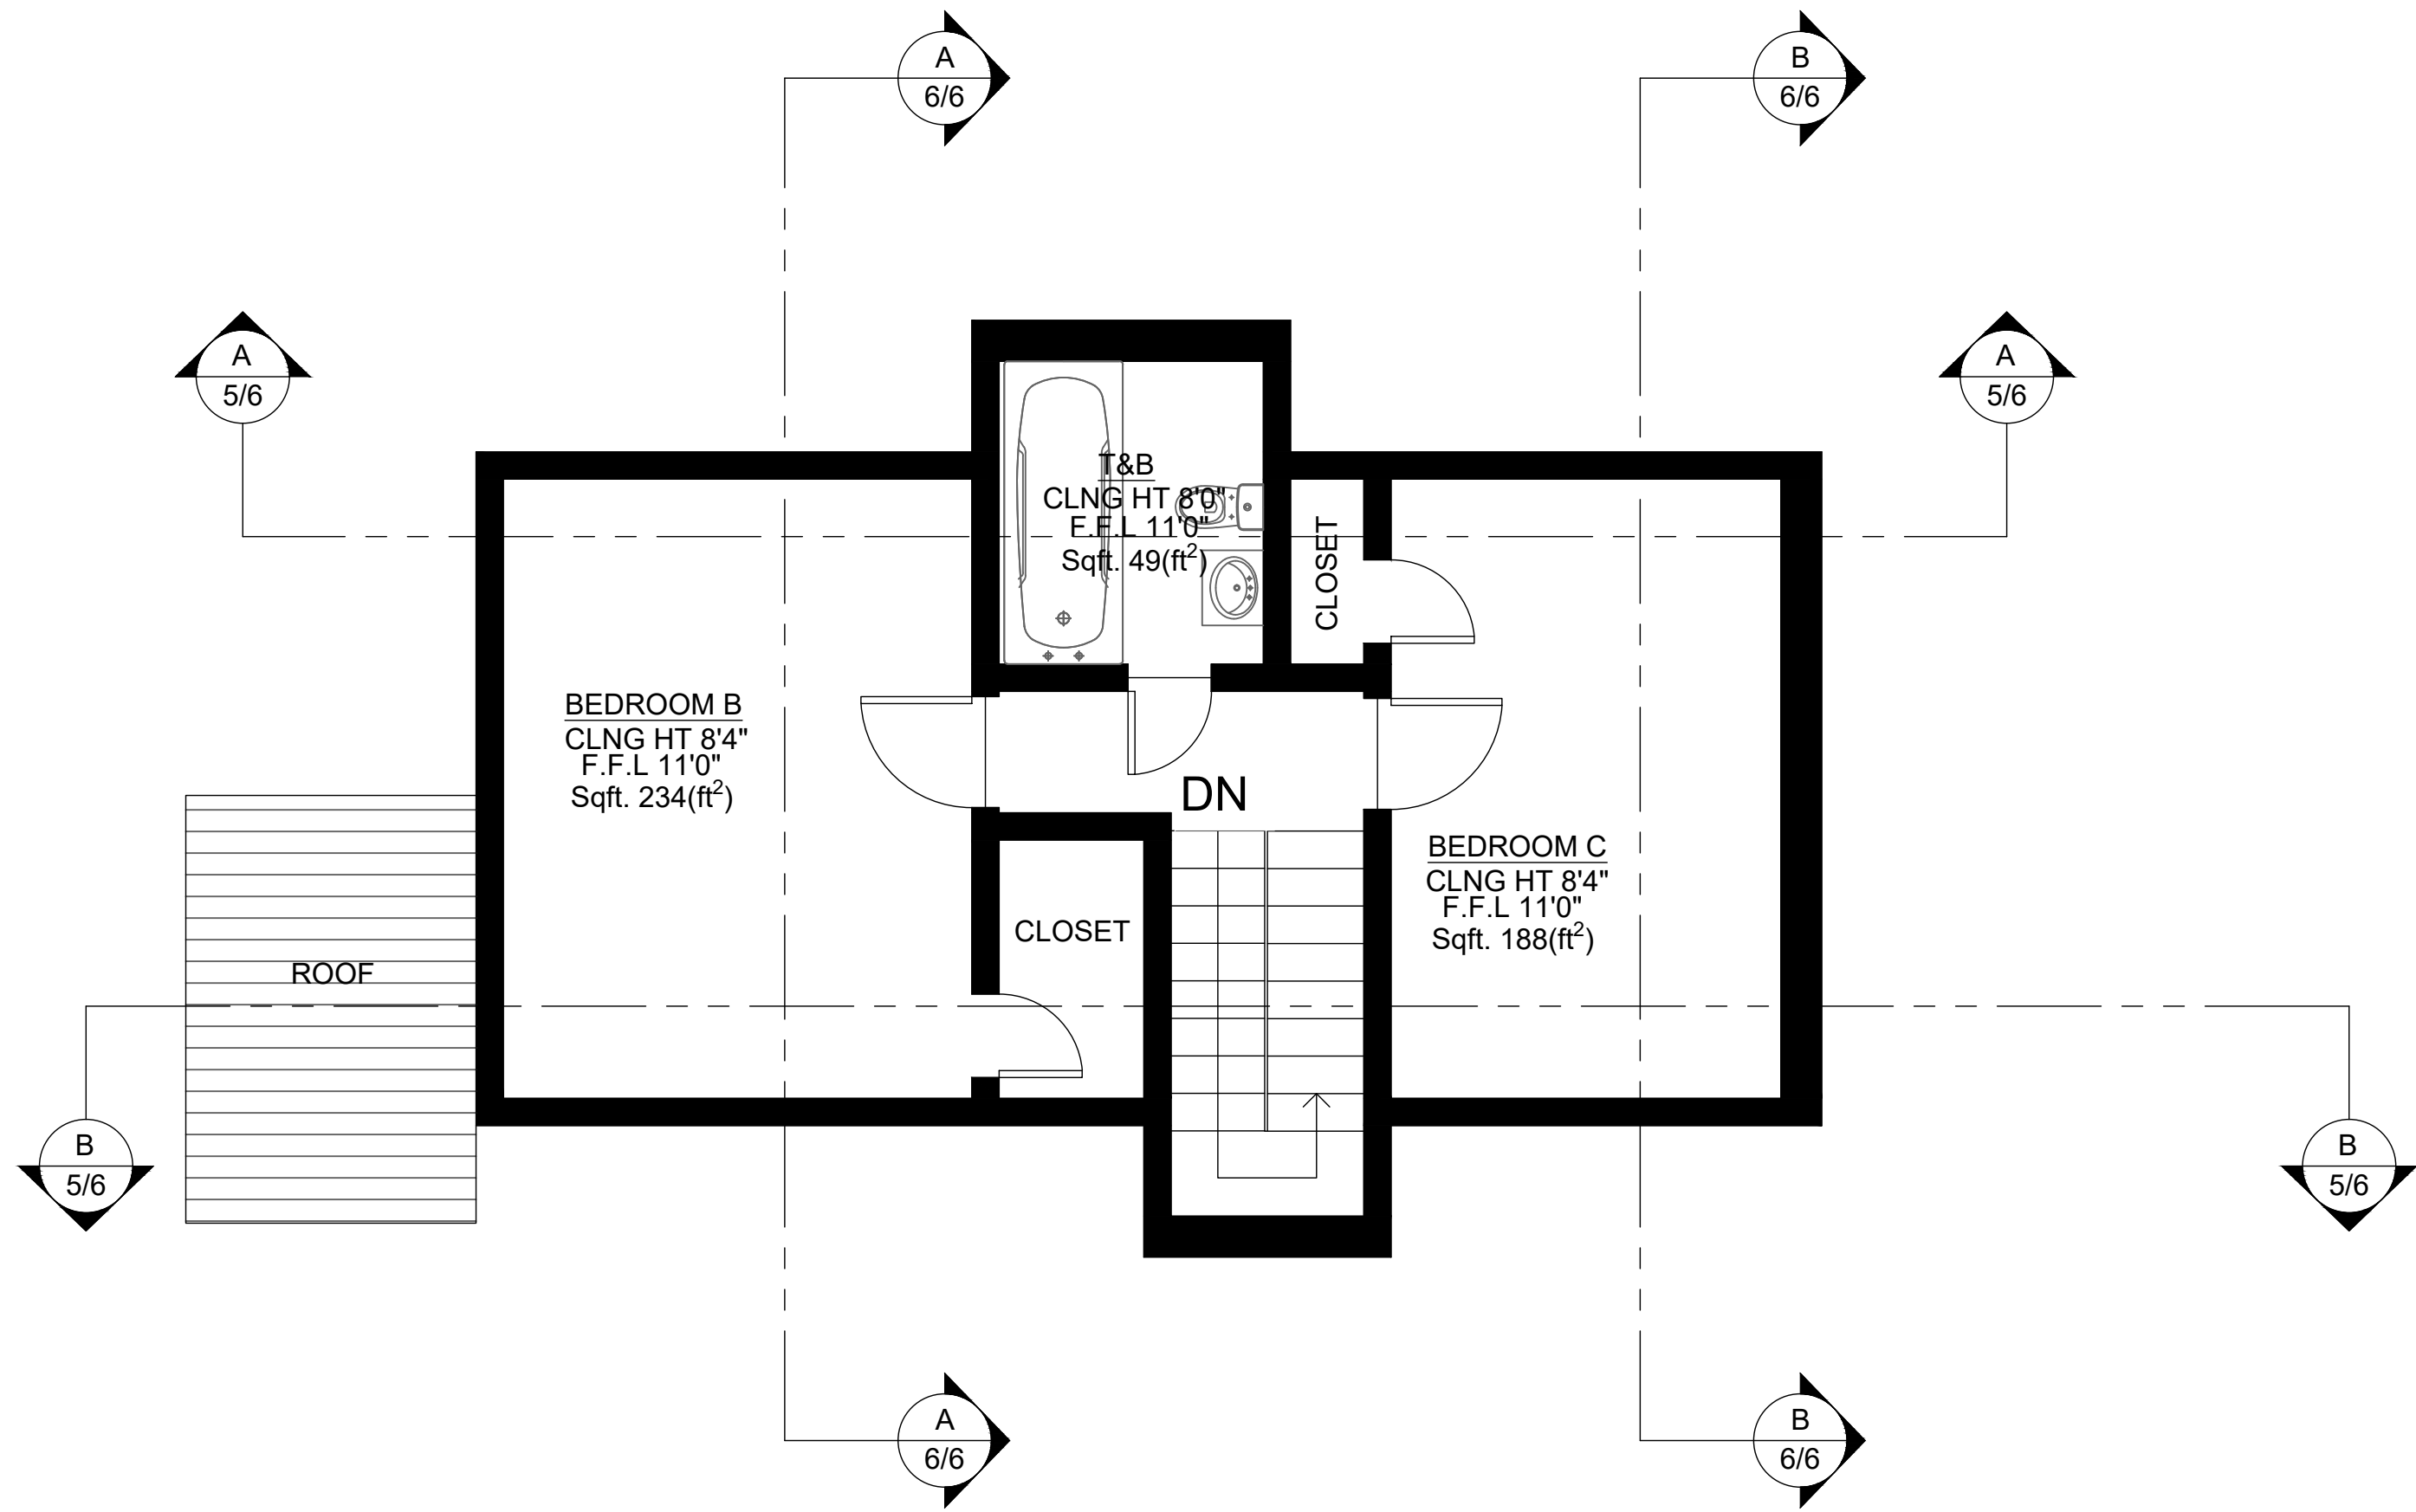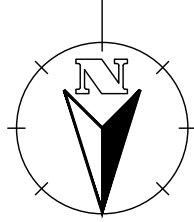

**A** SECOND FLOOR PLAN  
4/6 SCALE: 1/4"=1'-0"

**Notes:**

- 1. ALL PLANS ARE CREATED BY REALTY 360° VIEW AND MADE EXCLUSIVELY FOR REAL ESTATE MARKETING PURPOSES.
- 2. SIZED AND DIMENSIONS ARE APPROXIMATE. ACTUAL MAY VARY.

**WALL LEGEND**

	EXISTING WALL
--	---------------

**ABBREVIATIONS**

T.O.P	TOP OF PARAPET
B.O.J	BOTTOM OF JOIST
B.O.D	BOTTOM OF DUCT
B.O.D	BOTTOM OF DUCT
F.F.L	FINISH FLOOR LINE
N.G.L	NATURAL GRADE LINE
CH	CEILING HEIGHT

0	ISSUED FOR INFORMATION	RGE	10/11/20
REV:	DESCRIPTION:	BY:	DATE:

STATUS: **AS-BUILT**

REALTOR/BROKERAGE:

**LUXE REALTY**  
 Mobile: -  
 Office: (720) 575-1050  
 Email: admin@luxerealtydenver.com  
 Web: https://luxerealtydenver.com/



PRESENTED BY:

**REALTY 360° VIEW**  
 Call or Text Us at: 720-770-1230  
 Email Direct at: CR@Realty360View.com  
 Website: https://realty360view.com/  
 Address: 242 Linden St Fort Collins, CO 80524




SITE/:  
671 Elati St, Denver, CO 80204, USA

TITLE:  
AS-BUILT DRAWING

SCALE: 1/4" = 1'-0"	DATE: 10/11/20	DRAWN: RGE	APPROVED:
PROJECT NO: Prop.Tours/htb	SHEET NO: 4/6	PHASE: 0	



**A** LONGTITUDINAL SECTION A  
 5/6 SCALE: 1/4"=1'-0"

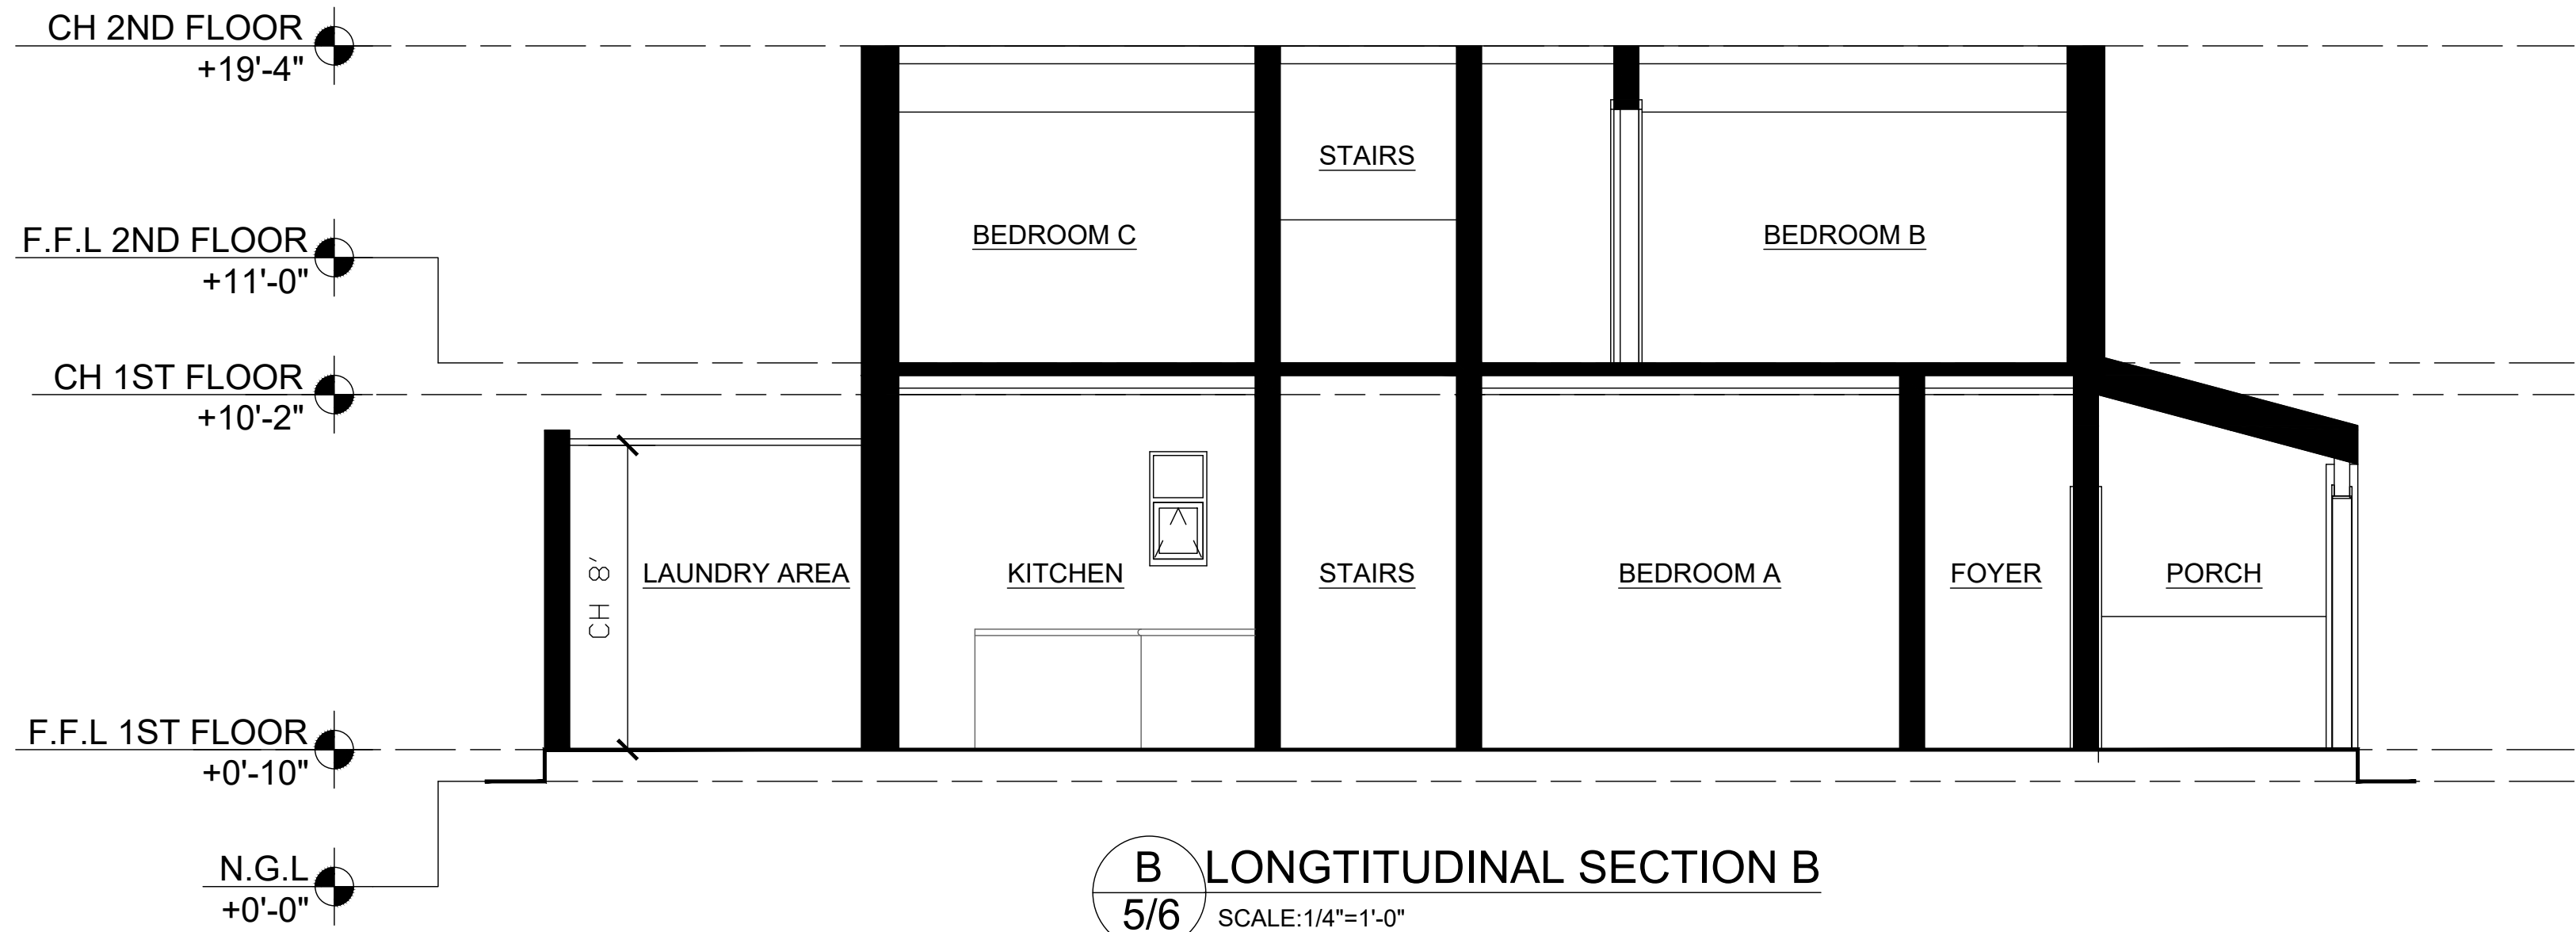

**B** LONGTITUDINAL SECTION B  
 5/6 SCALE: 1/4"=1'-0"

**Notes:**

- 1. ALL PLANS ARE CREATED BY REALTY 360° VIEW AND MADE EXCLUSIVELY FOR REAL ESTATE MARKETING PURPOSES.
- 2. SIZED AND DIMENSIONS ARE APPROXIMATE. ACTUAL MAY VARY.

**WALL LEGEND**

EXISTING WALL

**ABBREVIATIONS**

T.O.P	TOP OF PARAPET
B.O.J	BOTTOM OF JOIST
B.O.D	BOTTOM OF DUCT
B.O.D	BOTTOM OF DUCT
F.F.L	FINISH FLOOR LINE
N.G.L	NATURAL GRADE LINE
CH	CEILING HEIGHT

0	ISSUED FOR INFORMATION	RGE	10/11/20
REV:	DESCRIPTION:	BY:	DATE:

STATUS: **AS-BUILT**

REALTOR/BROKERAGE:

**LUXE REALTY**  
 Mobile: -  
 Office: (720) 575-1050  
 Email: admin@luxerealtydenver.com  
 Web: https://luxerealtydenver.com/



PRESENTED BY:


**REALTY 360° VIEW**  
 Call or Text Us at: 720-770-1230  
 Email Direct at: CR@Realty360View.com  
 Website: https://realty360view.com/  
 Address: 242 Linden St Fort Collins, CO 80524



SITE/: 671 Elati St, Denver, CO 80204, USA

TITLE: AS-BUILT DRAWING

SCALE: 1/4" = 1'-0"	DATE: 10/11/20	DRAWN: RGE	APPROVED:
PROJECT NO: Prop.Tours/htb	SHEET NO: 5/6	PHASE: 0	

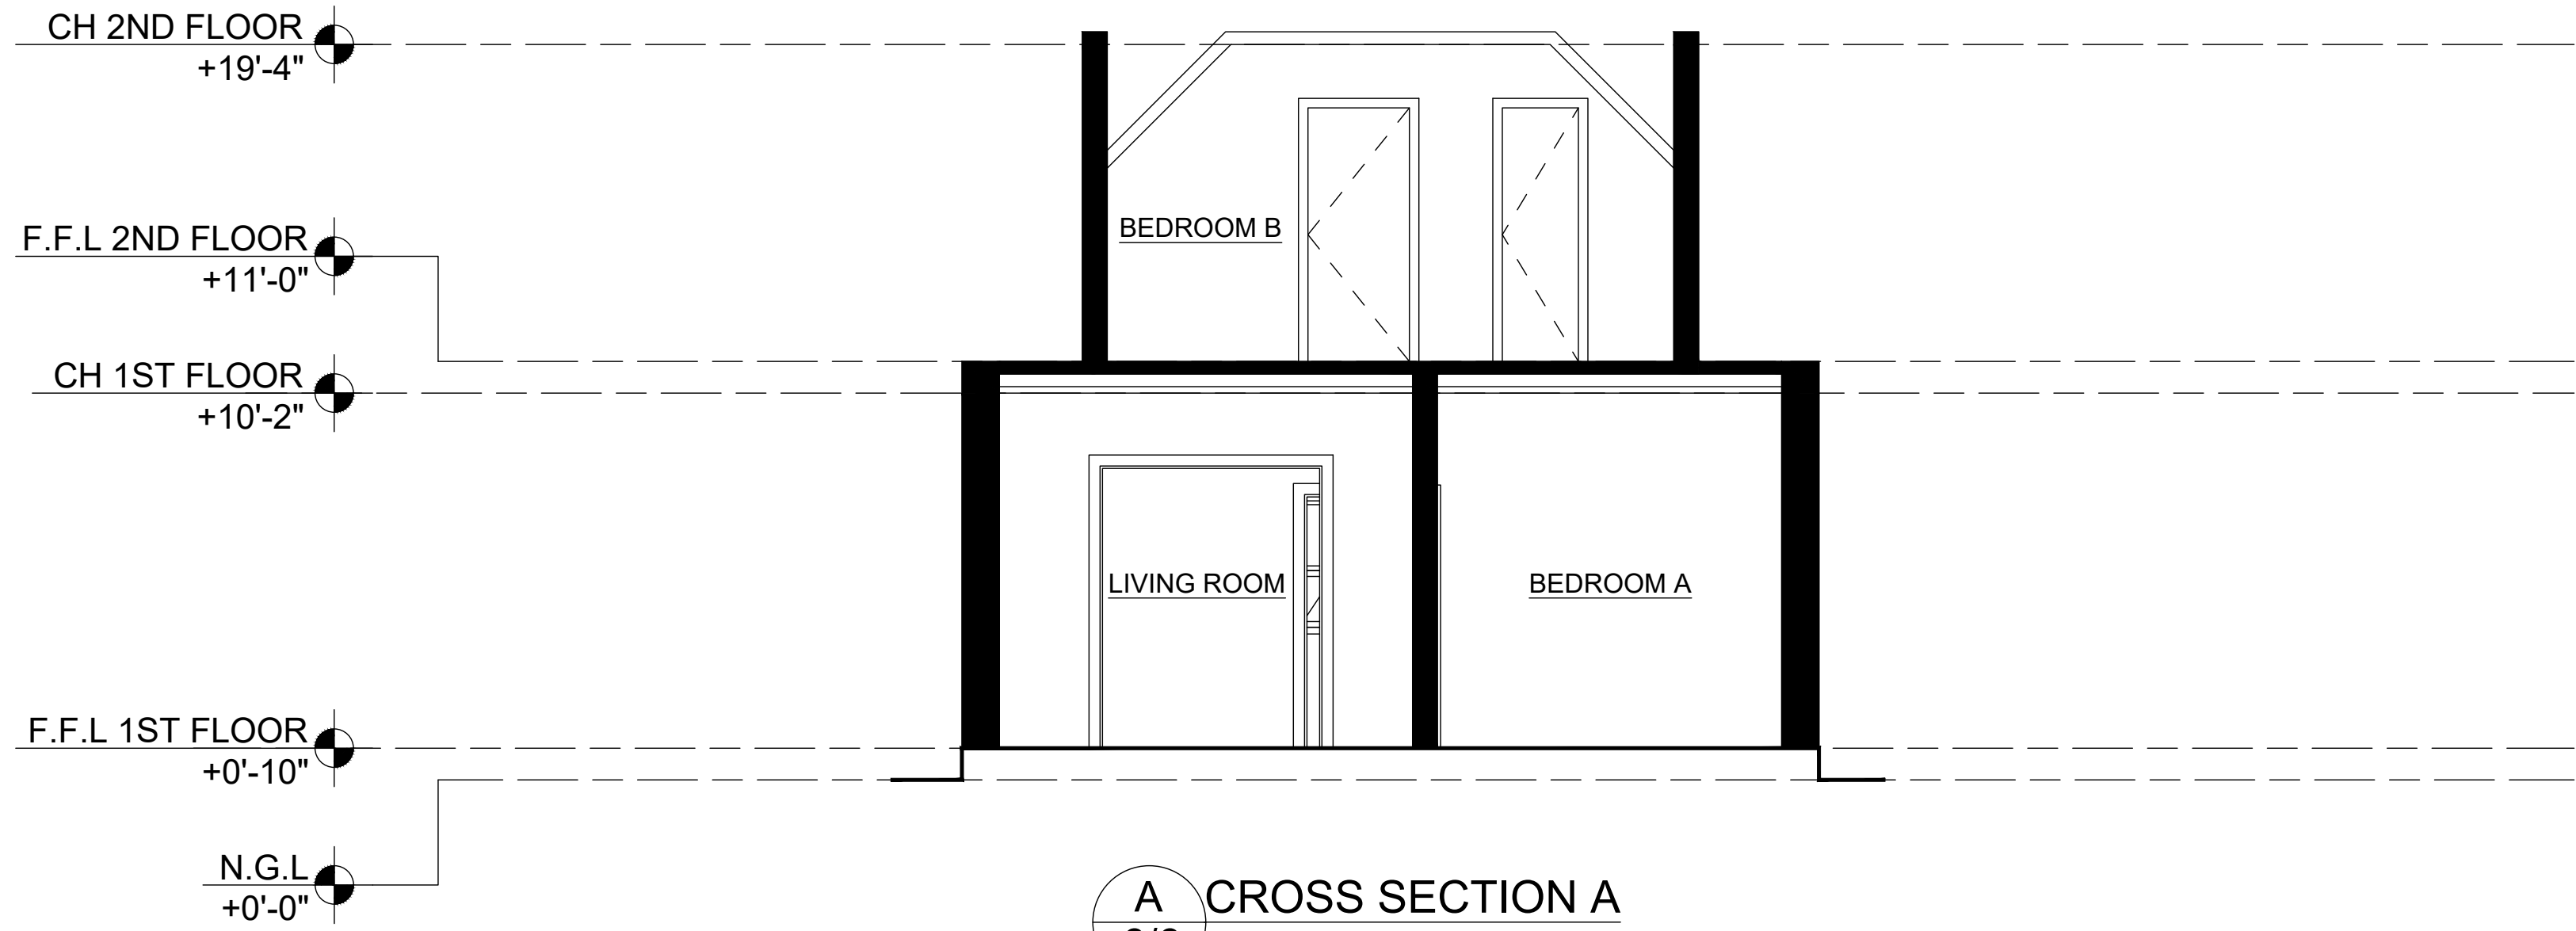

**A** CROSS SECTION A  
6/6 SCALE: 1/4"=1'-0"



**B** CROSSL SECTION B  
6/6 SCALE: 1/4"=1'-0"

**Notes:**

- 1. ALL PLANS ARE CREATED BY REALTY 360° VIEW AND MADE EXCLUSIVELY FOR REAL ESTATE MARKETING PURPOSES.
- 2. SIZED AND DIMENSIONS ARE APPROXIMATE. ACTUAL MAY VARY.

**WALL LEGEND**

	EXISTING WALL
--	---------------

**ABBREVIATIONS**

T.O.P	TOP OF PARAPET
B.O.J	BOTTOM OF JOIST
B.O.D	BOTTOM OF DUCT
B.O.D	BOTTOM OF DUCT
F.F.L	FINISH FLOOR LINE
N.G.L	NATURAL GRADE LINE
CH	CEILING HEIGHT

0	ISSUED FOR INFORMATION	RGE	10/11/20
REV:	DESCRIPTION:	BY:	DATE:

STATUS: **AS-BUILT**

REALTOR/BROKERAGE:

**LUXE REALTY**  
 Mobile: -  
 Office: (720) 575-1050  
 Email: admin@luxerealtydenver.com  
 Web: https://luxerealtydenver.com/



PRESENTED BY:

**REALTY 360° VIEW**  
 Call or Text Us at: 720-770-1230  
 Email Direct at: CR@Realty360View.com  
 Website: https://realty360view.com/  
 Address: 242 Linden St Fort Collins, CO 80524



SITE/:  
671 Elati St, Denver, CO 80204, USA

TITLE:  
AS-BUILT DRAWING

SCALE: 1/4" = 1'-0"	DATE: 10/11/20	DRAWN: RGE	APPROVED:
PROJECT NO: Prop.Tours/htb	SHEET NO: 6/6	PHASE: 0	