


LOCATION MAP

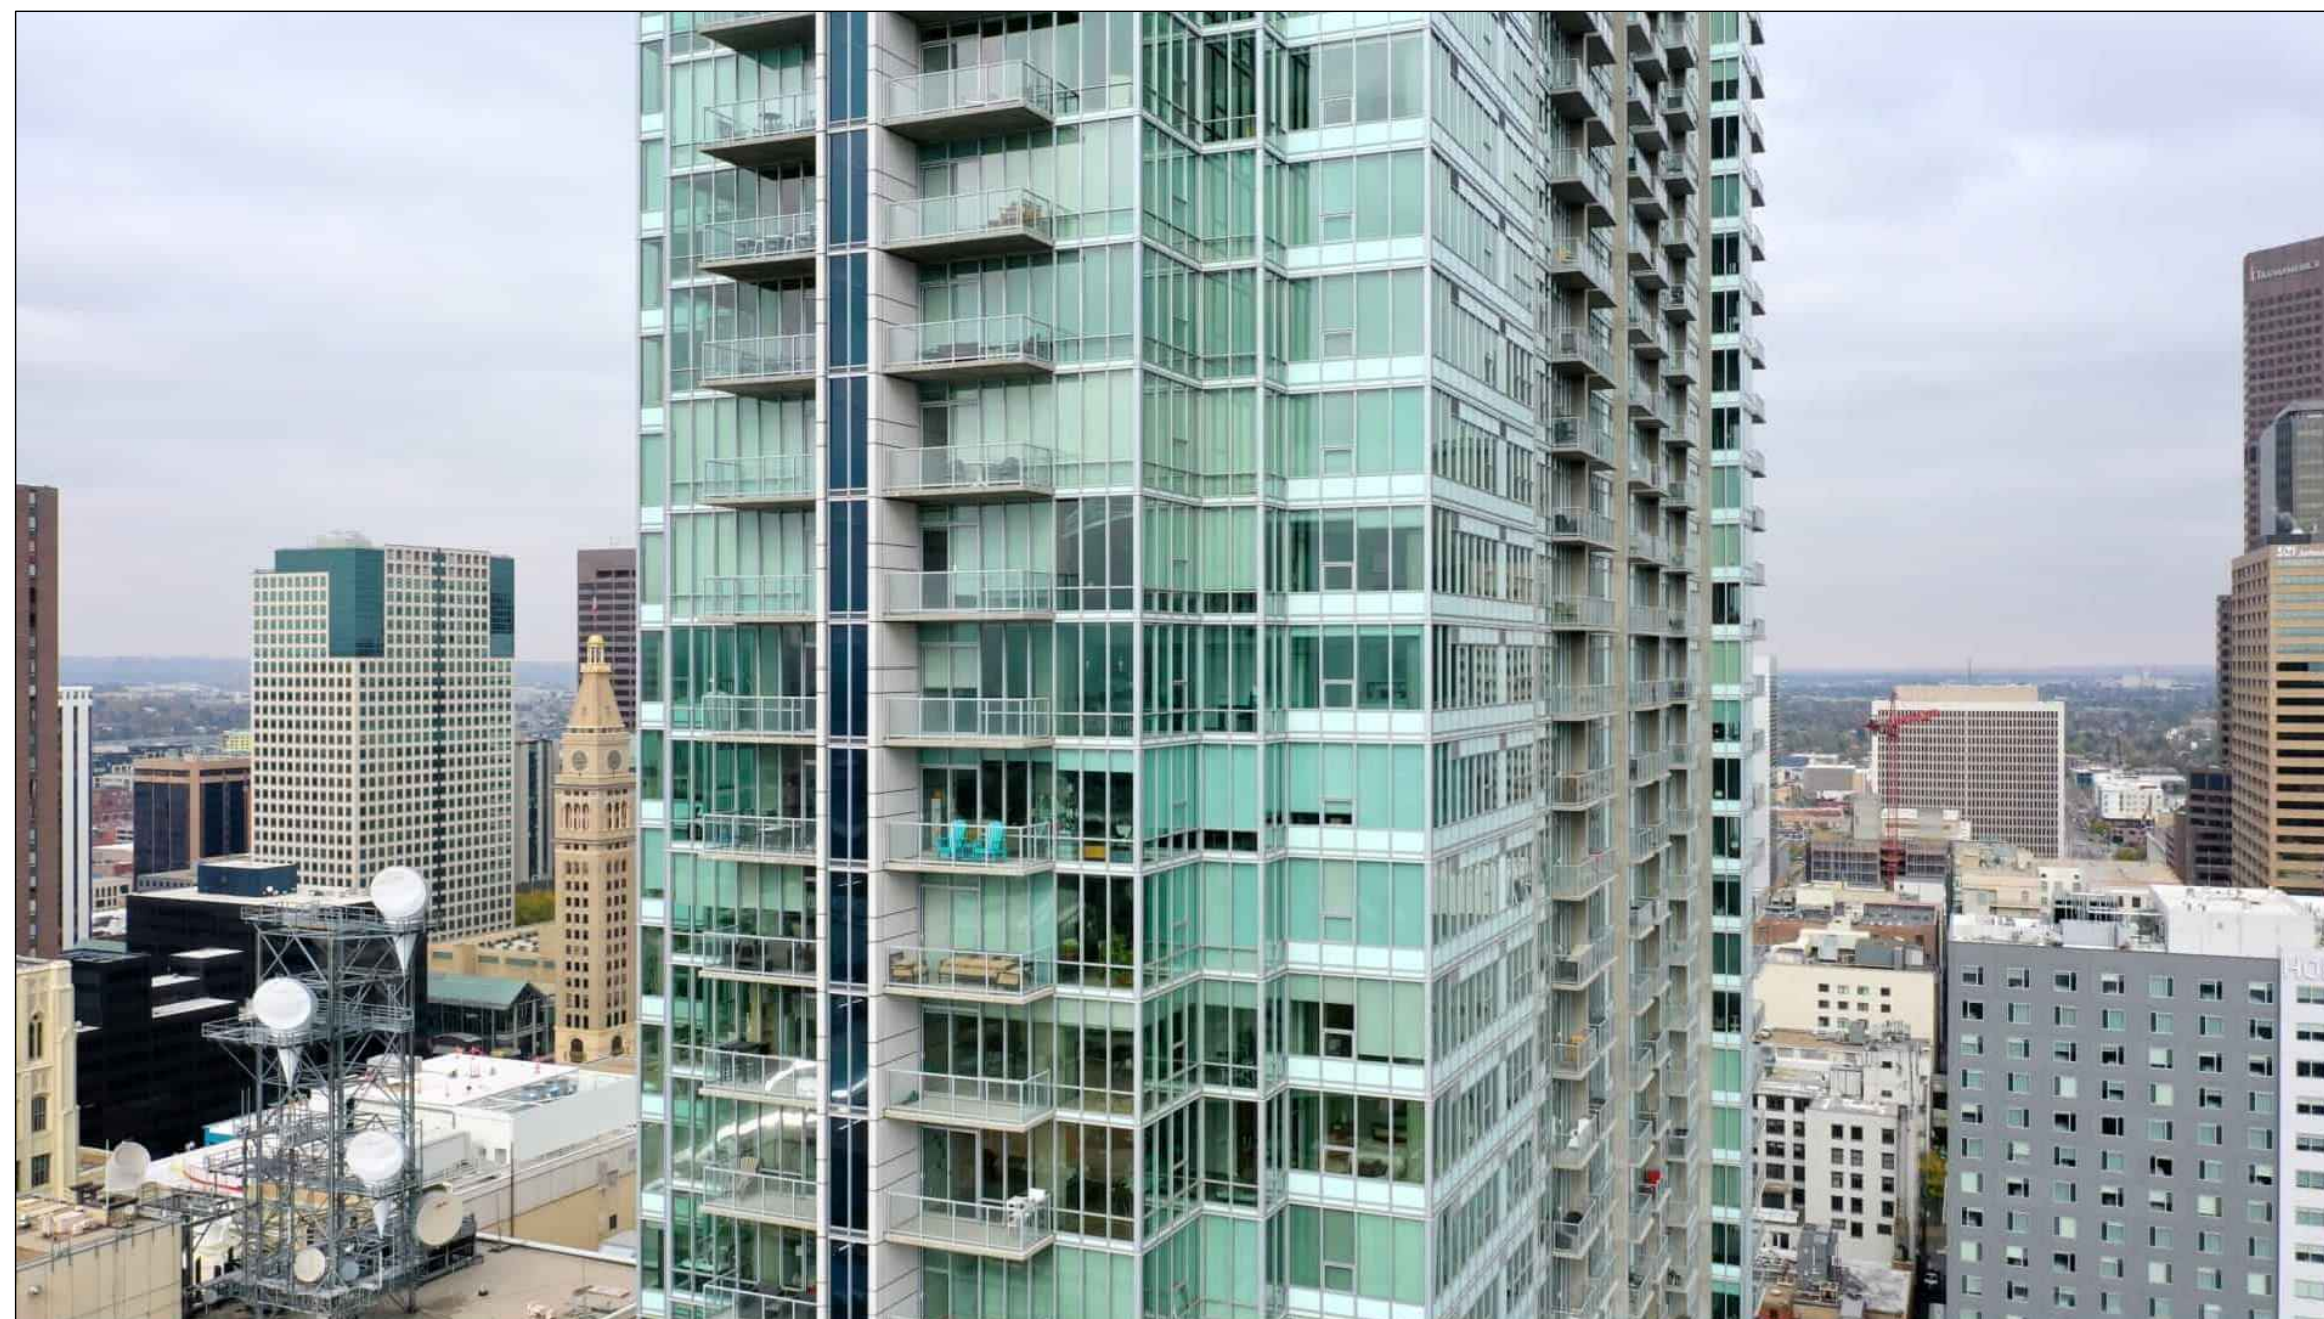

STREET VIEW

Notes:

1. ALL PLANS ARE CREATED BY REALTY 360° VIEW AND MADE EXCLUSIVELY FOR REAL ESTATE MARKETING PURPOSES.  
 2. SIZED AND DIMENSIONS ARE APPROXIMATE. ACTUAL MAY VARY.

1	ISSUED FOR INFORMATION	MAB	10/28/20
PHASE	DESCRIPTION:	BY:	DATE:

STATUS: **AS-BUILT**

REALTOR/BROKERAGE:  
**SCOTT CRAFT**  
 Mobile: (720) 308-9697  
 Office: (720) 308-9697  
 Email: scott@crafthomescolorado.com  
 Web: <https://www.crafthomescolorado.com/>



PRESENTED BY:  
**REALTY 360° VIEW**  
 Call or Text Us at: 720-770-1230  
 Email Direct at: CR@Realty360View.com  
 Website: <https://realty360view.com/>  
 Address: 242 Linden St Fort Collins, CO 80524




SITE/:  
 891 14TH ST. #3017 DENVER, CO 80202, USA

TITLE:  
 AS-BUILT DRAWING

SCALE:	DATE:	DRAWN:	APPROVED:
NTS	10/28/20	MAB	RGE
PROJECT NO:	SHEET NO:	PHASE:	
Prop.Tours/gke	1/5	1	



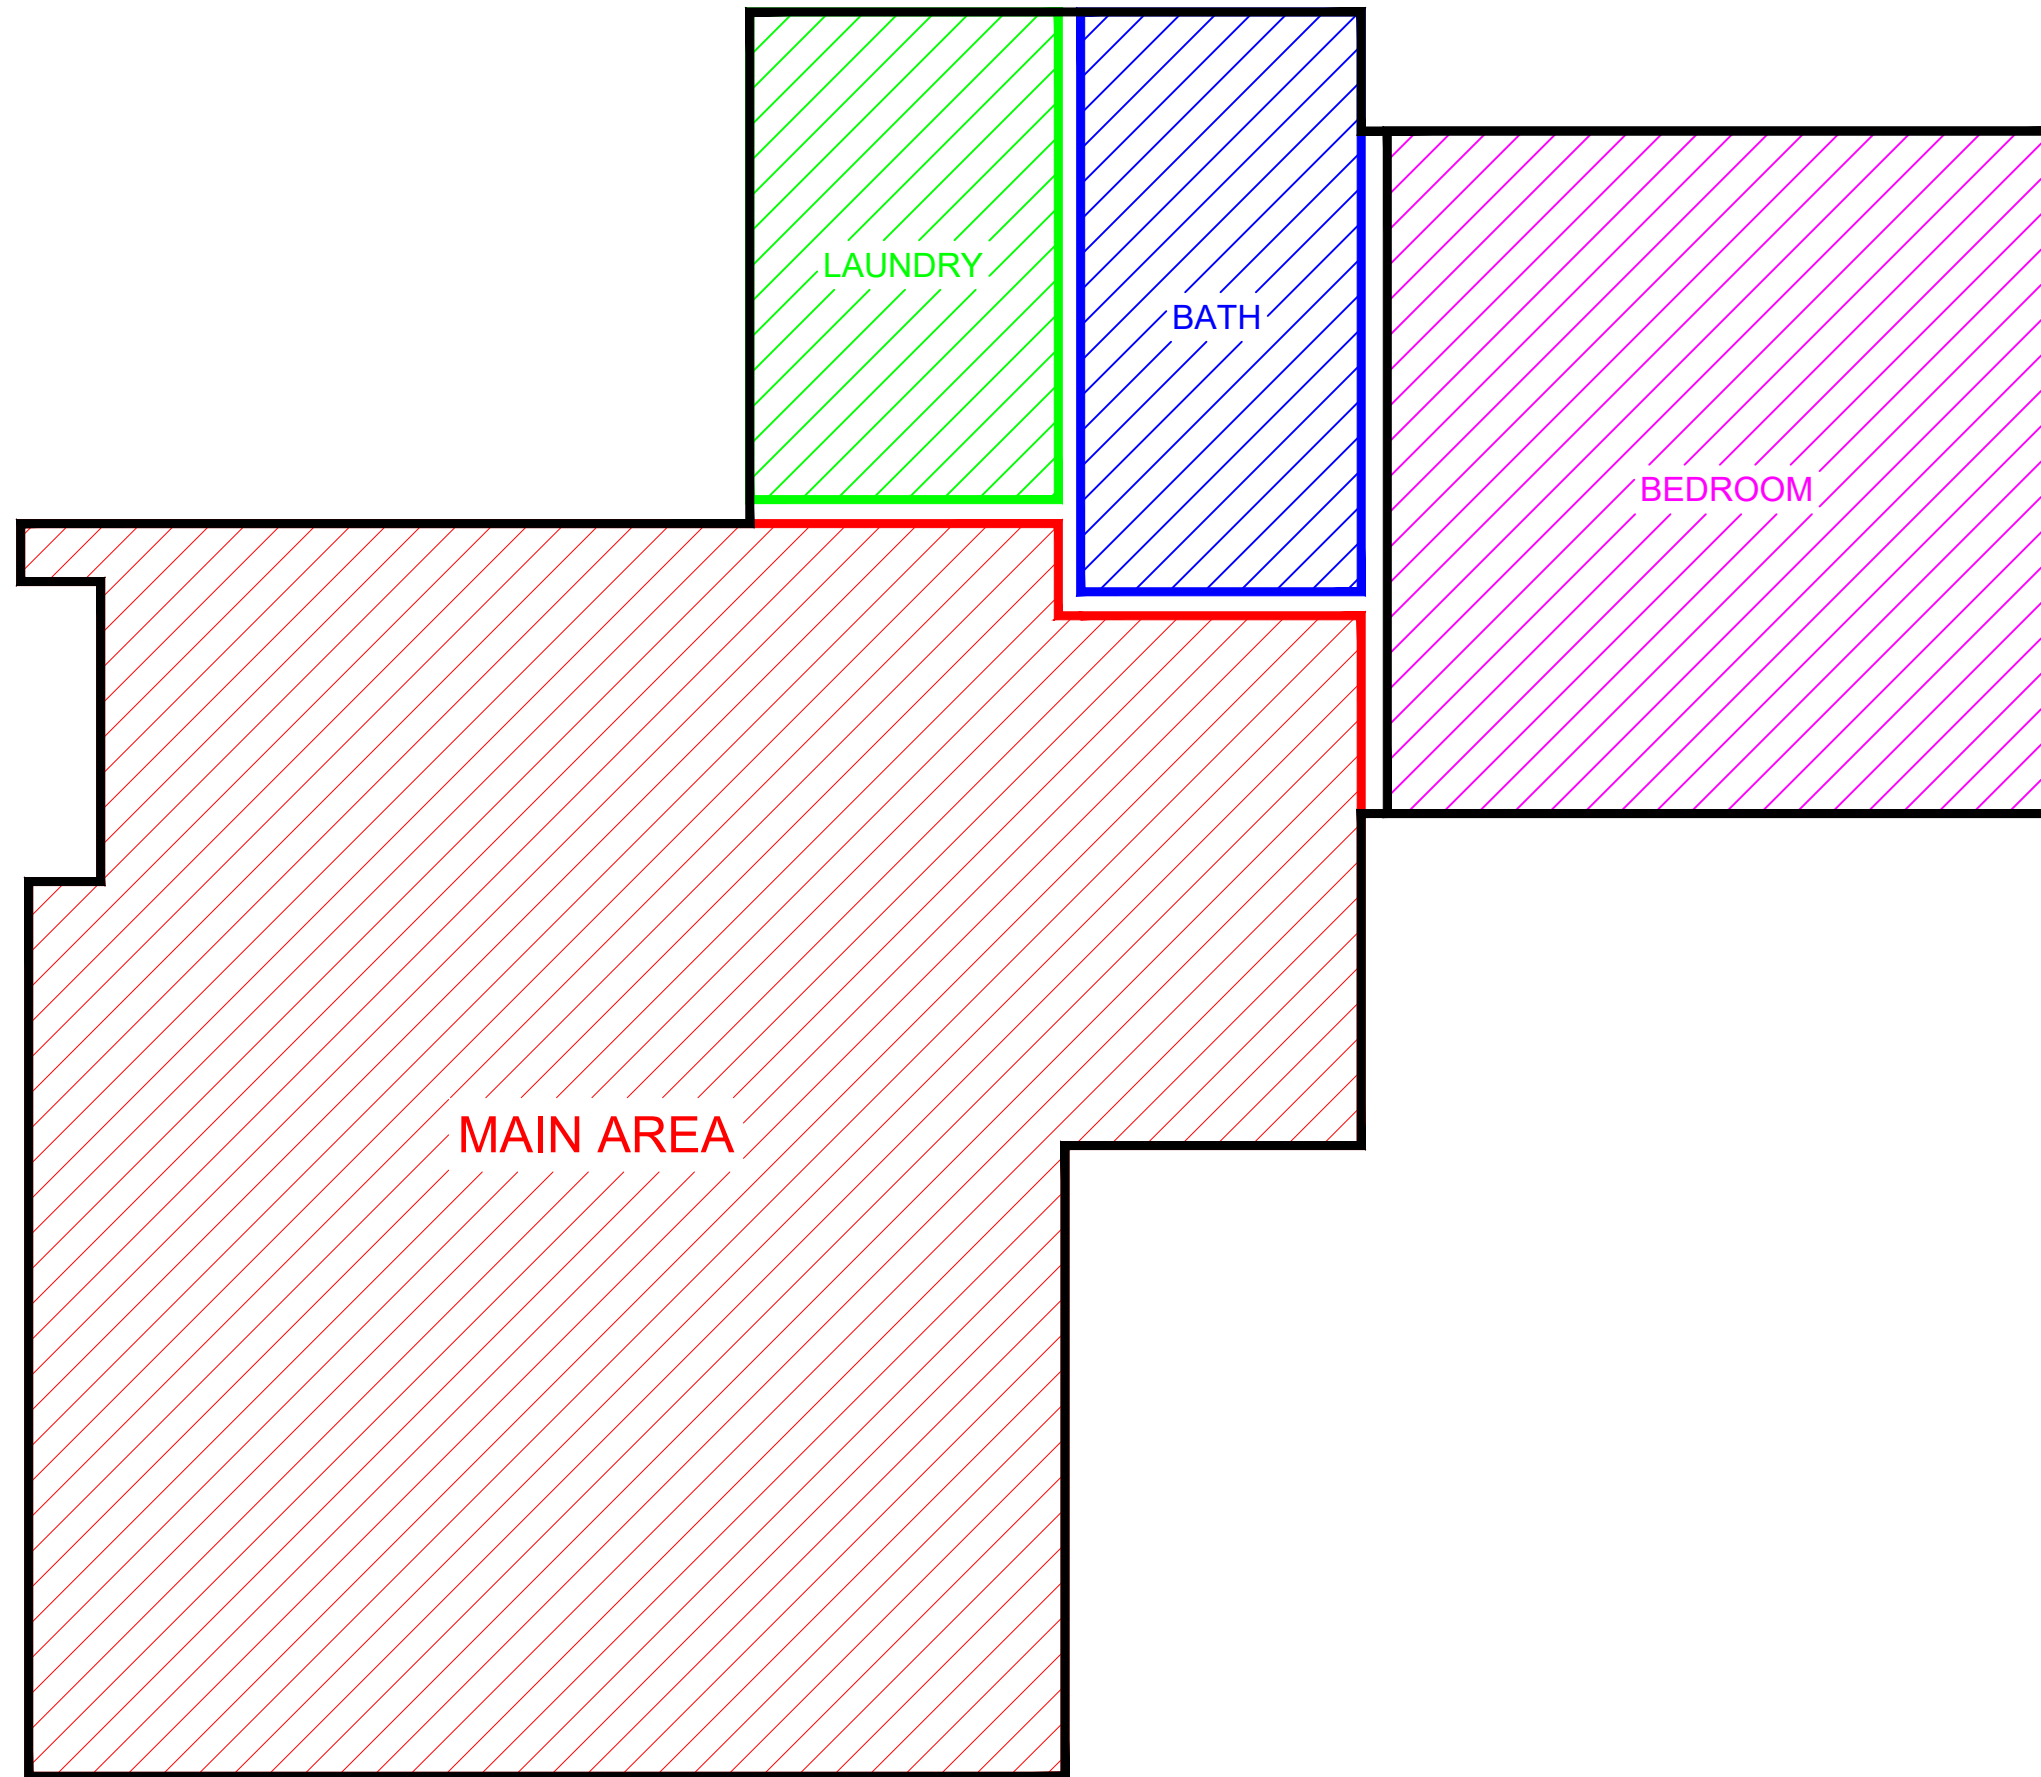

FLOOR AREA	
MAIN AREA	622sqft (ft <sup>2</sup> )
BEDROOM	201sqft (ft <sup>2</sup> )
BATH	70sqft (ft <sup>2</sup> )
LAUNDRY	65sqft (ft <sup>2</sup> )
TOTAL AREA	978sqft (ft <sup>2</sup> )

**Notes:**

1. ALL PLANS ARE CREATED BY REALTY 360° VIEW AND MADE EXCLUSIVELY FOR REAL ESTATE MARKETING PURPOSES.  
 2. SIZED AND DIMENSIONS ARE APPROXIMATE. ACTUAL MAY VARY.

1	ISSUED FOR INFORMATION	MAB	10/28/20
PHASE	DESCRIPTION:	BY:	DATE:

STATUS: **AS-BUILT**

REALTOR/BROKERAGE:  
**SCOTT CRAFT**  
 Mobile: (720) 308-9697  
 Office: (720) 308-9697  
 Email: scott@crafthomescolorado.com  
 Web: https://www.crafthomescolorado.com/




PRESENTED BY:  
**REALTY 360° VIEW**  
 Call or Text Us at: 720-770-1230  
 Email Direct at: CR@Realty360View.com  
 Website: https://realty360view.com/  
 Address: 242 Linden St Fort Collins, CO 80524



SITE/:  
 891 14TH ST. #3017 DENVER, CO 80202, USA

TITLE:  
 AS-BUILT DRAWING


SCALE: 1/4"=1'-0"	DATE: 10/28/20	DRAWN: MAB	APPROVED: RGE
PROJECT NO: Prop.Tours/gke	SHEET NO: 2/5	PHASE: 1	

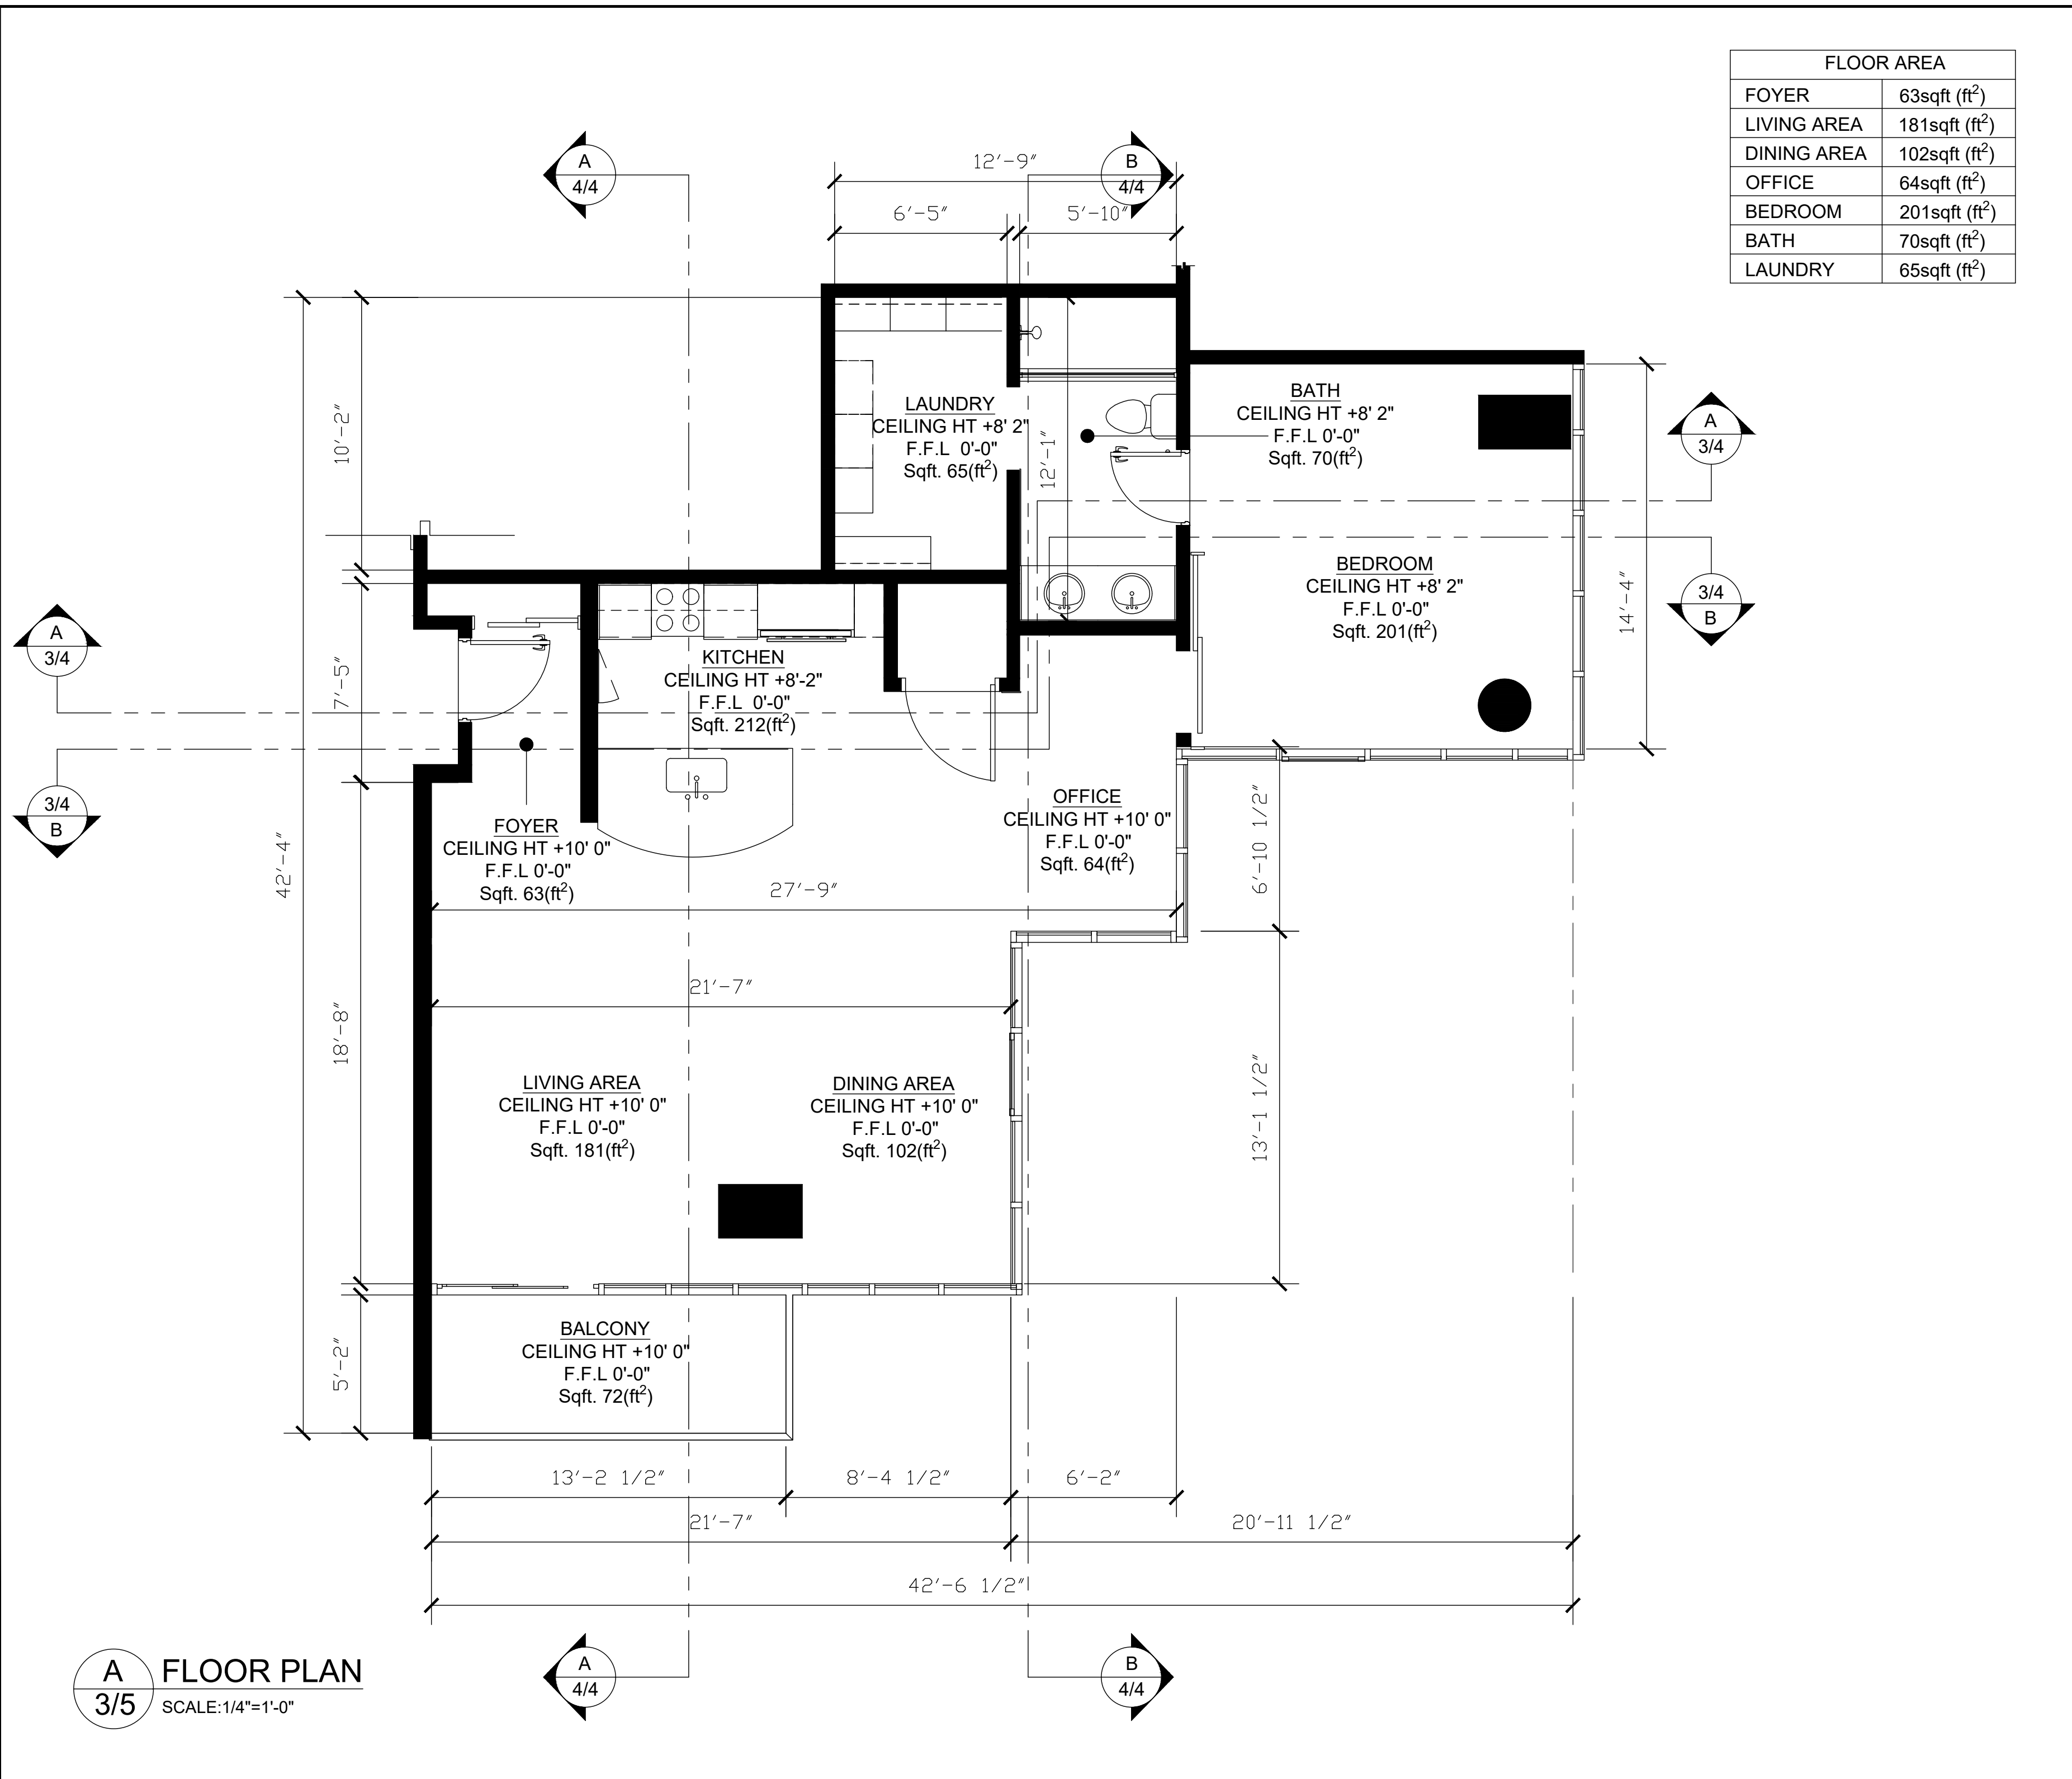

FLOOR AREA	
FOYER	63sqft (ft <sup>2</sup> )
LIVING AREA	181sqft (ft <sup>2</sup> )
DINING AREA	102sqft (ft <sup>2</sup> )
OFFICE	64sqft (ft <sup>2</sup> )
BEDROOM	201sqft (ft <sup>2</sup> )
BATH	70sqft (ft <sup>2</sup> )
LAUNDRY	65sqft (ft <sup>2</sup> )

**Notes:**

1. ALL PLANS ARE CREATED BY REALTY 360° VIEW AND MADE EXCLUSIVELY FOR REAL ESTATE MARKETING PURPOSES.
2. SIZED AND DIMENSIONS ARE APPROXIMATE. ACTUAL MAY VARY.

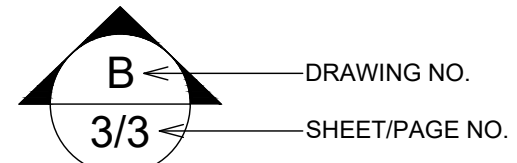

**WALL LEGEND**

EXISTING WALL

**ABBREVIATIONS**

T.O.P	TOP OF PARAPET
B.O.J	BOTTOM OF JOIST
B.O.D	BOTTOM OF DUCT
B.O.D	BOTTOM OF DUCT
F.F.L	FINISH FLOOR LINE
N.G.L	NATURAL GRADE LINE
CH	CEILING HEIGHT

1	ISSUED FOR INFORMATION	MAB	10/28/20
PHASE	DESCRIPTION:	BY:	DATE:

STATUS: **AS-BUILT**

REALTOR/BROKERAGE:

**SCOTT CRAFT**  
 Mobile: (720) 308-9697  
 Office: (720) 308-9697  
 Email: scott@crafthomescolorado.com  
 Web: <https://www.crafthomescolorado.com/>

**CRAFT HOMES REALTY**

PRESENTED BY:

**REALTY 360° VIEW**  
 Call or Text Us at: 720-770-1230  
 Email Direct at: CR@Realty360View.com  
 Website: <https://realty360view.com/>  
 Address: 242 Linden St Fort Collins, CO 80524

**REALTY 360° VIEW**

SITE/:  
 891 14TH ST. #3017 DENVER, CO 80202, USA

TITLE:  
 AS-BUILT DRAWING


SCALE: 1/4"=1'-0"	DATE: 10/28/20	DRAWN: MAB	APPROVED: RGE
PROJECT NO: Prop.Tours/gke	SHEET NO: 3/5	PHASE: 1	

**Notes:**

- 1. ALL PLANS ARE CREATED BY REALTY 360° VIEW AND MADE EXCLUSIVELY FOR REAL ESTATE MARKETING PURPOSES.
- 2. SIZED AND DIMENSIONS ARE APPROXIMATE. ACTUAL MAY VARY.



**A** LONGTITUDINAL SECTION A  
4/5 SCALE: 1/4"=1'-0"

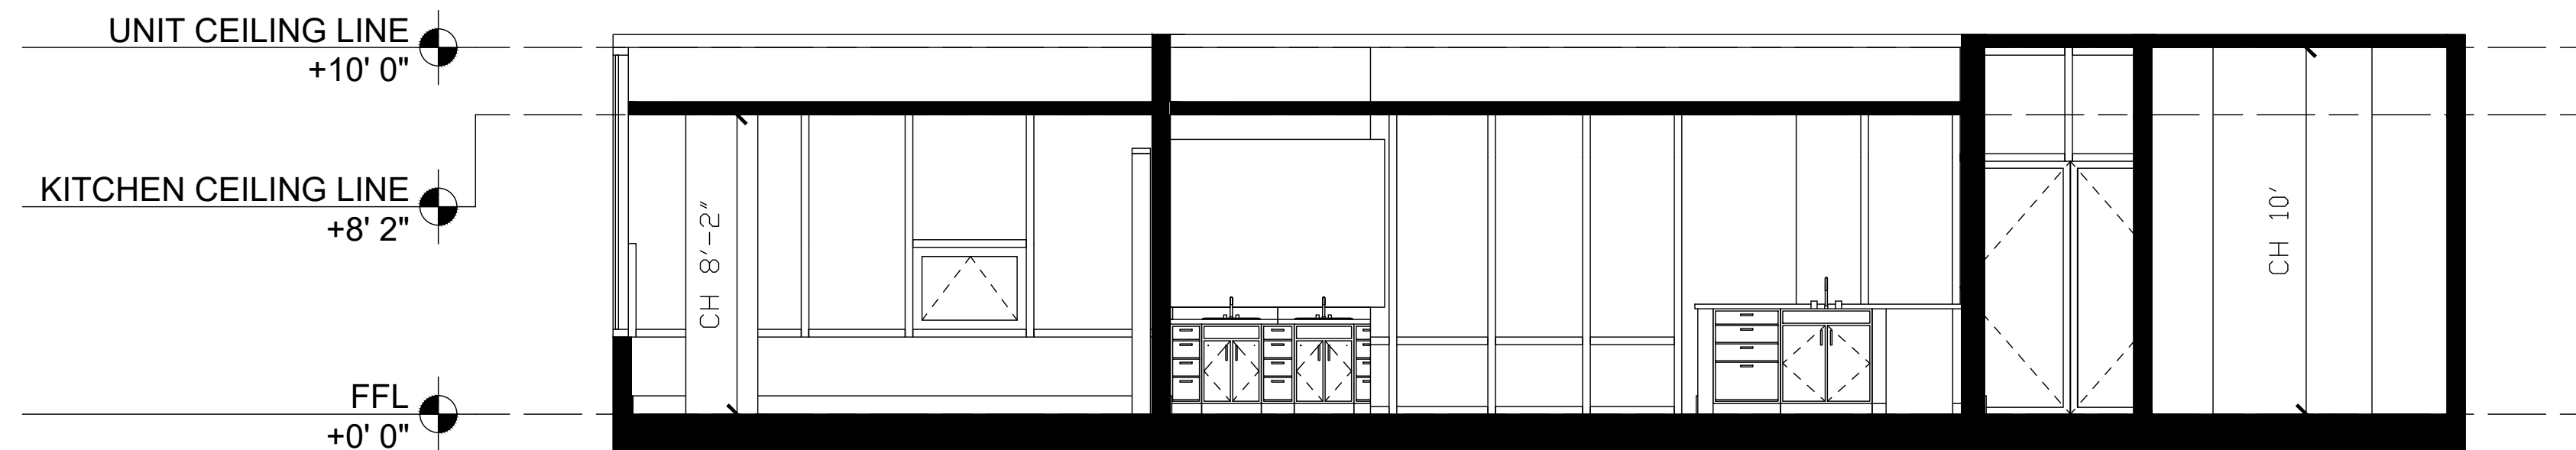

**B** LONGTITUDINAL SECTION B  
4/5 SCALE: 1/4"=1'-0"

**WALL LEGEND**

	EXISTING WALL
--	---------------

**ABBREVIATIONS**

T.O.P	TOP OF PARAPET
B.O.J	BOTTOM OF JOIST
B.O.D	BOTTOM OF DUCT
B.O.D	BOTTOM OF DUCT
F.F.L	FINISH FLOOR LINE
N.G.L	NATURAL GRADE LINE
CH	CEILING HEIGHT

1	ISSUED FOR INFORMATION	MAB	10/28/20
PHASE	DESCRIPTION:	BY:	DATE:

STATUS: **AS-BUILT**

REALTOR/BROKERAGE:

**SCOTT CRAFT**  
 Mobile: (720) 308-9697  
 Office: (720) 308-9697  
 Email: scott@crafthomescolorado.com  
 Web: <https://www.crafthomescolorado.com/>



PRESENTED BY:

**REALTY 360° VIEW**  
 Call or Text Us at: 720-770-1230  
 Email Direct at: CR@Realty360View.com  
 Website: <https://realty360view.com/>  
 Address: 242 Linden St Fort Collins, CO 80524




SITE/:  
891 14TH ST. #3017 DENVER, CO 80202, USA

TITLE:  
AS-BUILT DRAWING


SCALE: 1/4"=1'-0"	DATE: 10/28/20	DRAWN: MAB	APPROVED: RGE
PROJECT NO: Prop.Tours/gke	SHEET NO: 4/5	PHASE: 1	

Notes:

- 1. ALL PLANS ARE CREATED BY REALTY 360° VIEW AND MADE EXCLUSIVELY FOR REAL ESTATE MARKETING PURPOSES.
- 2. SIZED AND DIMENSIONS ARE APPROXIMATE. ACTUAL MAY VARY.

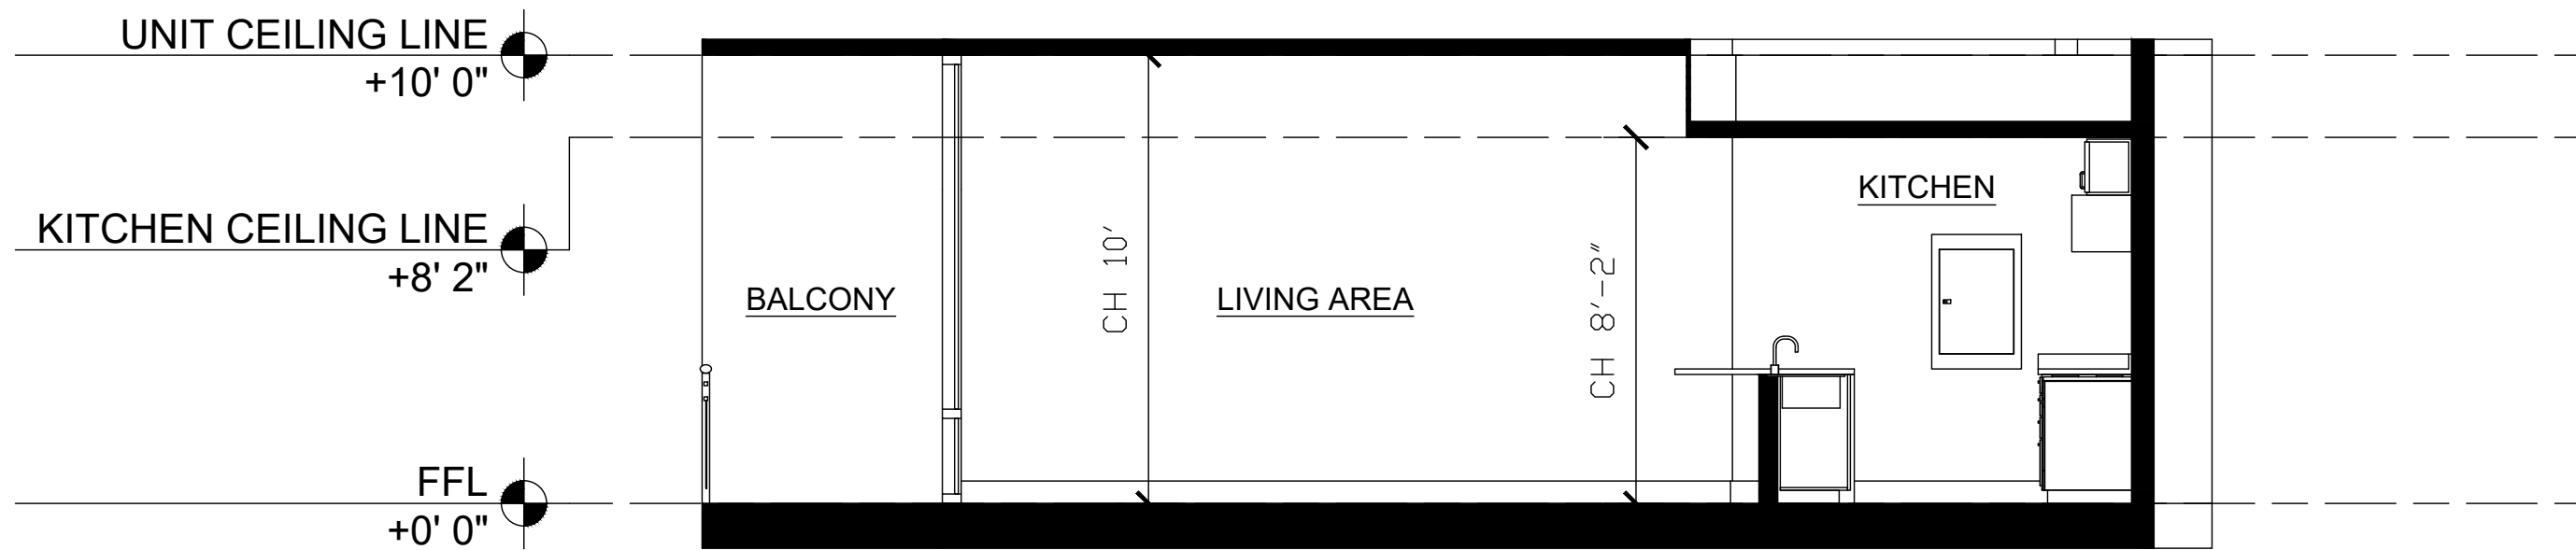

**A** CROSS SECTION A  
5/5 SCALE: 1/4"=1'-0"

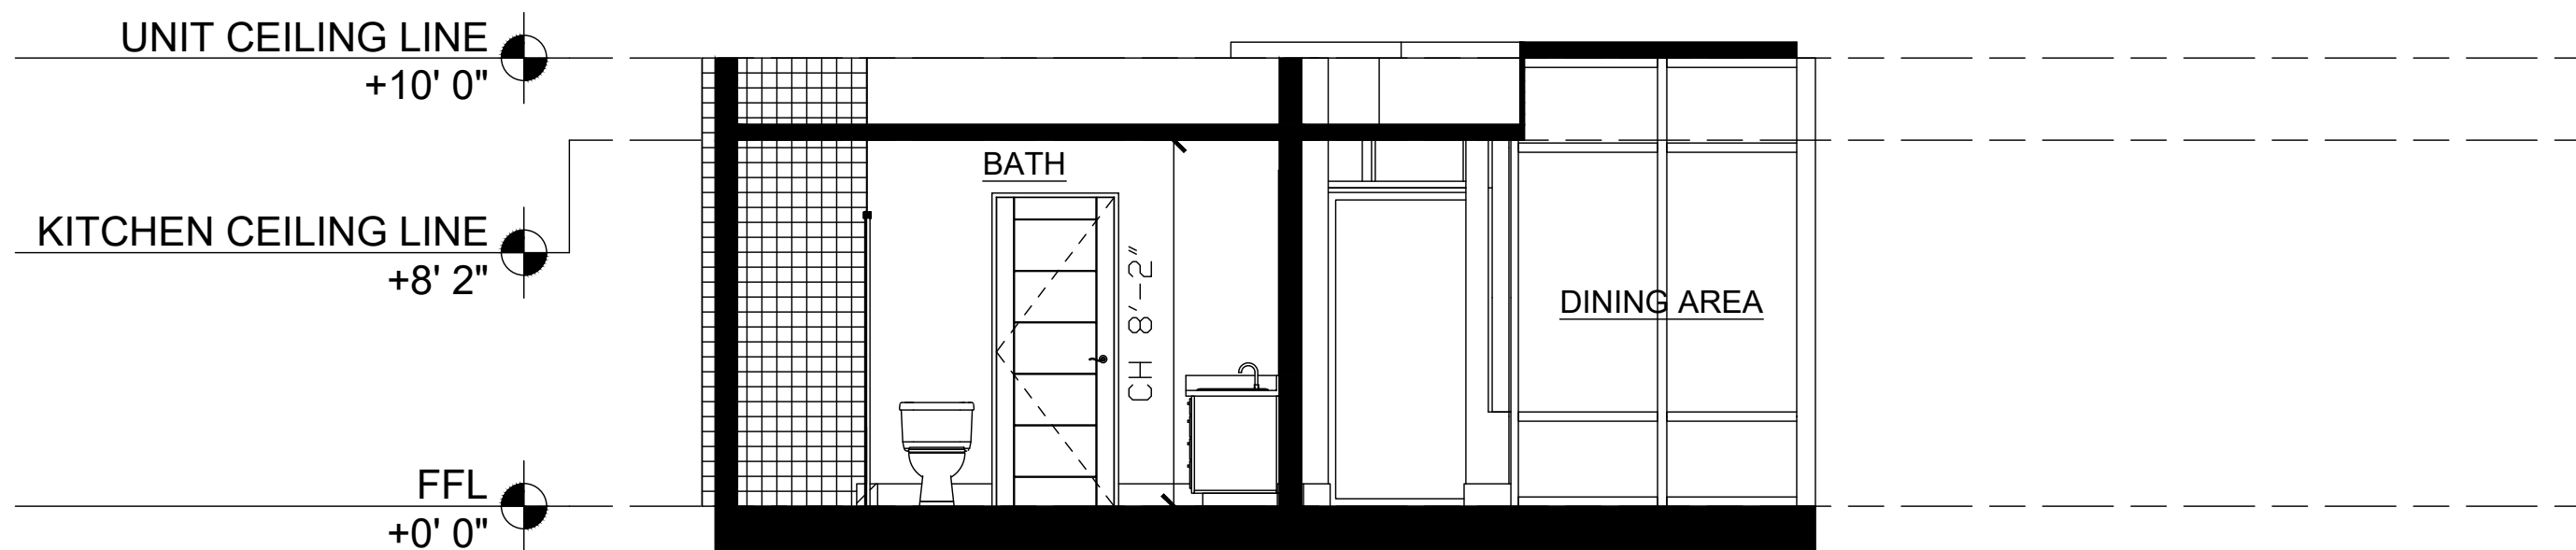

**B** CROSS SECTION B  
5/5 SCALE: 1/4"=1'-0"

WALL LEGEND

	EXISTING WALL
--	---------------

ABBREVIATIONS

T.O.P	TOP OF PARAPET
B.O.J	BOTTOM OF JOIST
B.O.D	BOTTOM OF DUCT
B.O.D	BOTTOM OF DUCT
F.F.L	FINISH FLOOR LINE
N.G.L	NATURAL GRADE LINE
CH	CEILING HEIGHT

1	ISSUED FOR INFORMATION	MAB	10/28/20
PHASE	DESCRIPTION:	BY:	DATE:

STATUS: **AS-BUILT**

REALTOR/BROKERAGE:

**SCOTT CRAFT**  
 Mobile: (720) 308-9697  
 Office: (720) 308-9697  
 Email: scott@crafthomescolorado.com  
 Web: <https://www.crafthomescolorado.com/>



PRESENTED BY:

**REALTY 360° VIEW**  
 Call or Text Us at: 720-770-1230  
 Email Direct at: CR@Realty360View.com  
 Website: <https://realty360view.com/>  
 Address: 242 Linden St Fort Collins, CO 80524



SITE: 891 14TH ST. #3017 DENVER, CO 80202, USA

TITLE: **AS-BUILT DRAWING**

SCALE: 1/4"=1'-0"	DATE: 10/28/20	DRAWN: MAB	APPROVED: RGE
PROJECT NO: Prop.Tours/gke	SHEET NO: 5/5	PHASE: 1	