


LOCATION MAP

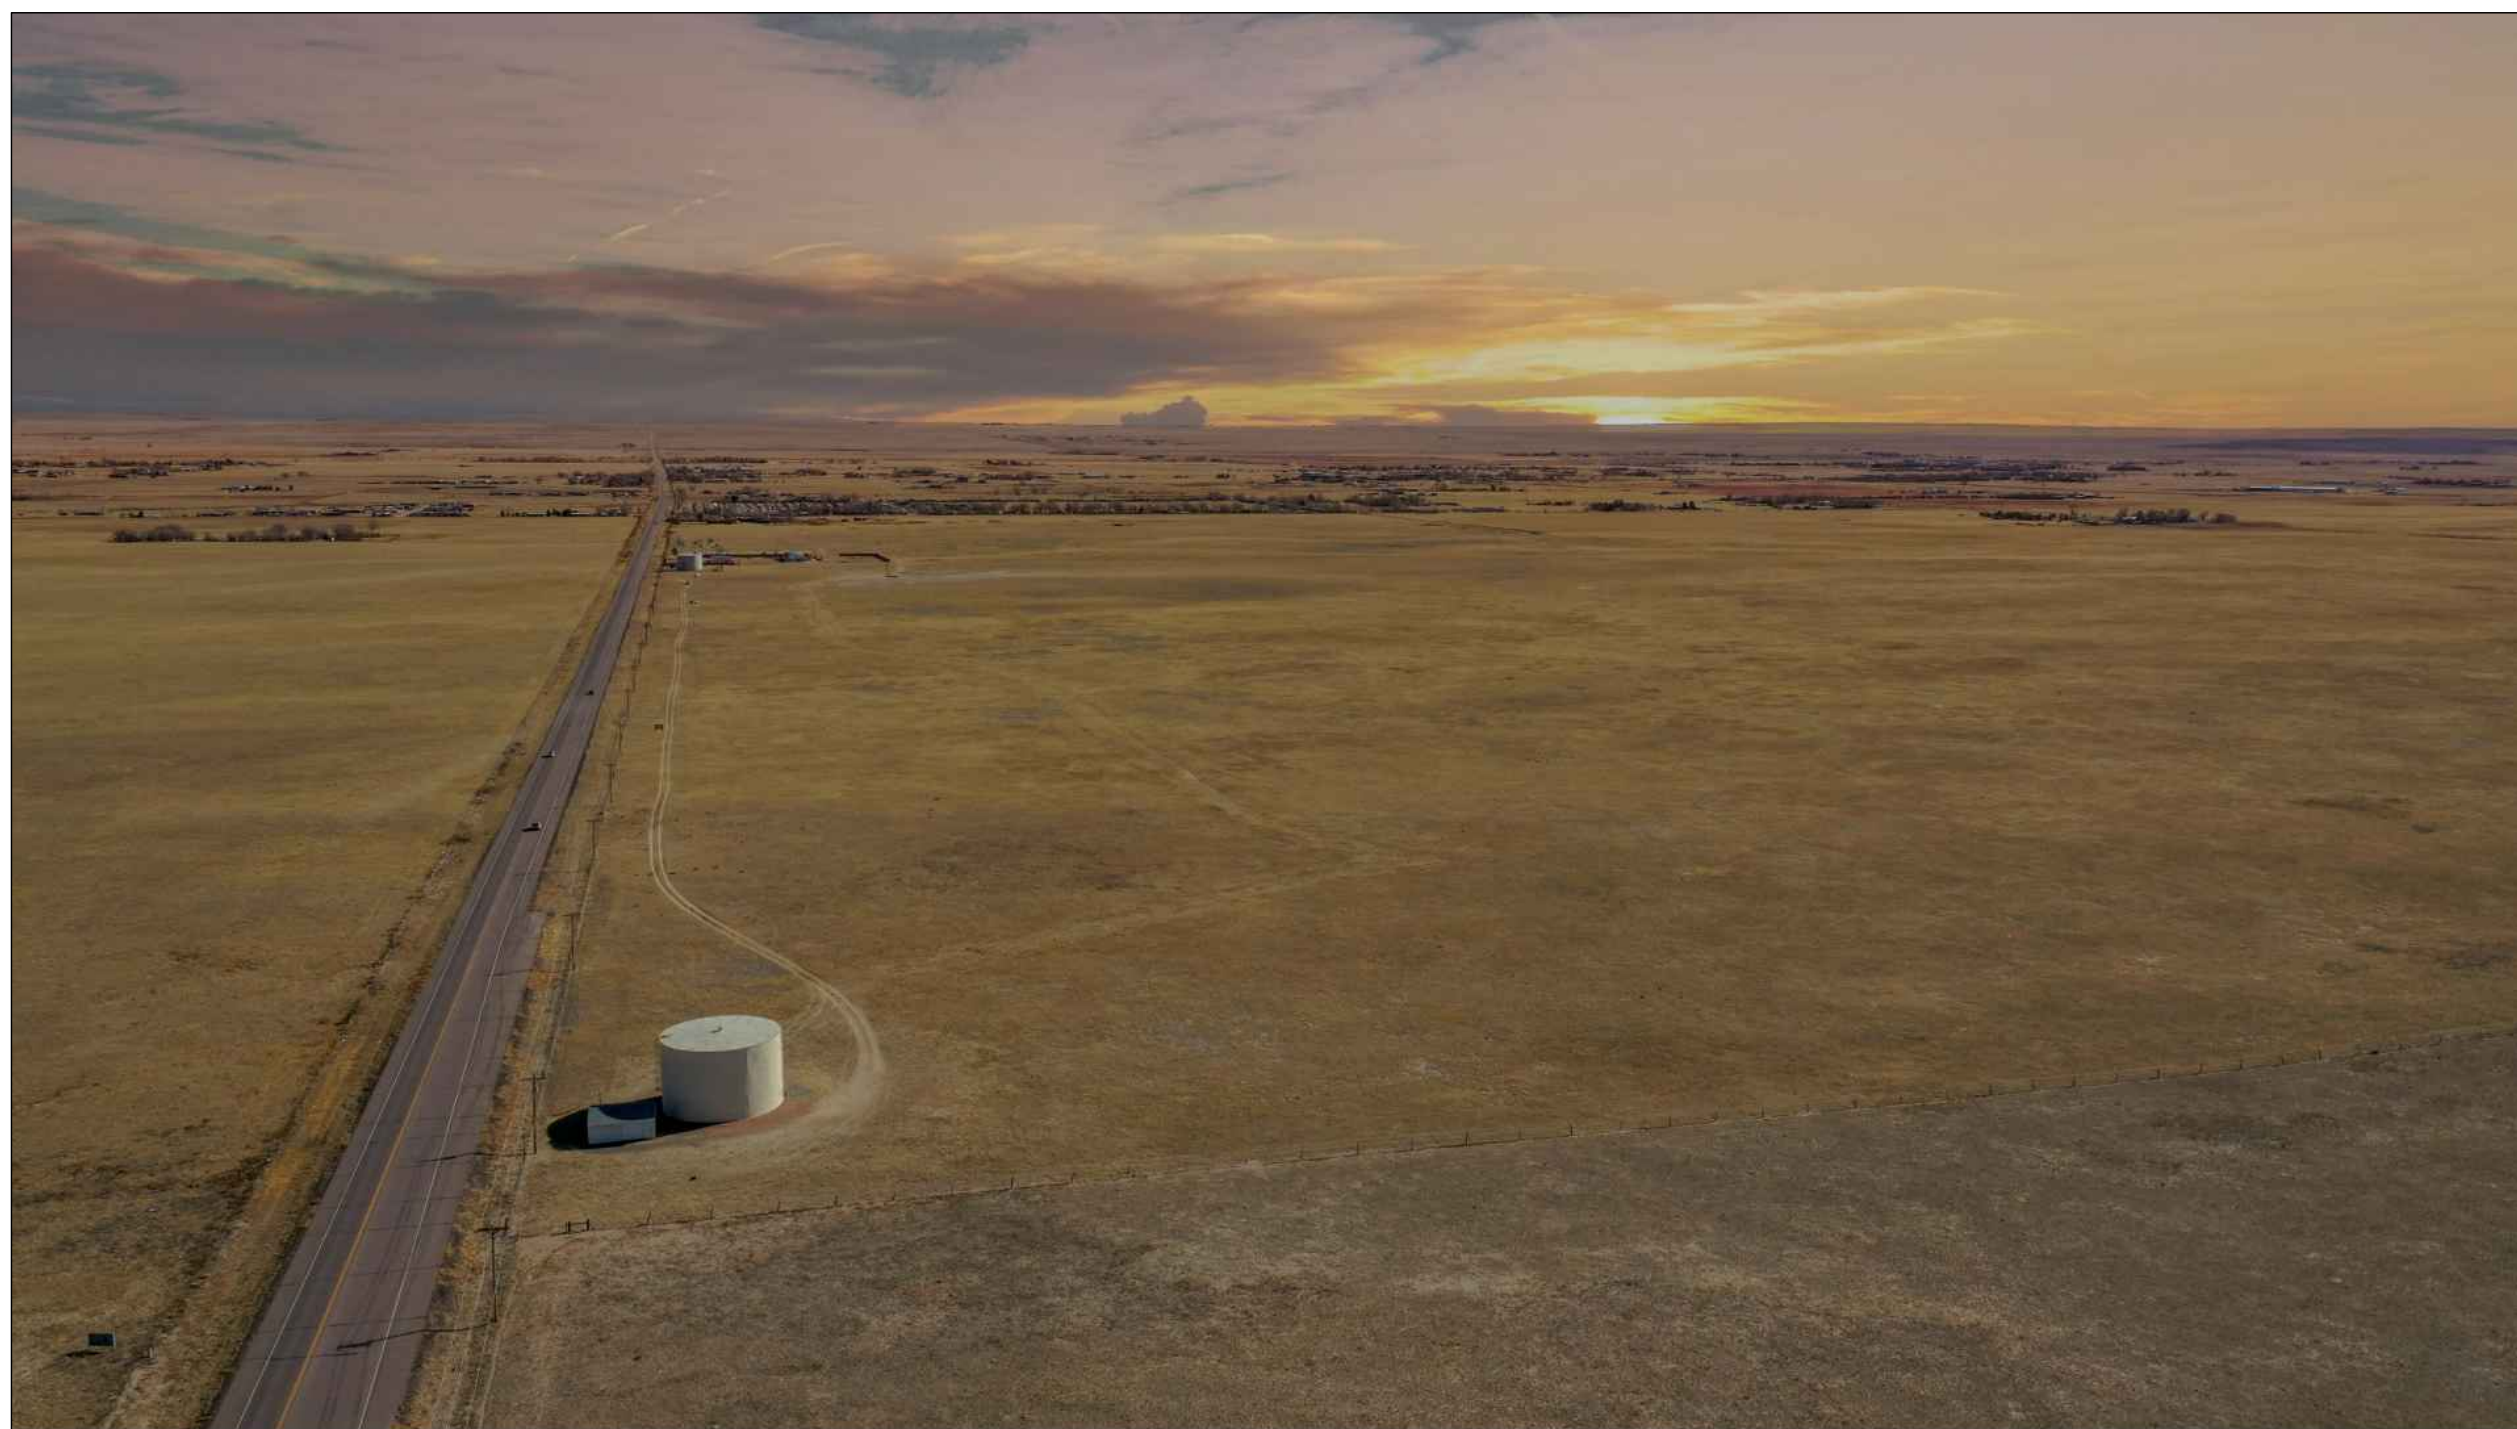

STREET VIEW


Notes:

- 1. ALL PLANS ARE CREATED BY REALTY 360° VIEW AND MADE EXCLUSIVELY FOR REAL ESTATE MARKETING PURPOSES.
- 2. SIZED AND DIMENSIONS ARE APPROXIMATE. ACTUAL MAY VARY.

1	ISSUED FOR INFORMATION	RGE	02/18/21
PHASE:	DESCRIPTION:	BY:	DATE:

STATUS: **AS-BUILT**

REALTOR/BROKERAGE:  
**TREASURE DAVIS TEAM**  
 Mobile: (719) 398-7190  
 Office:  
 Email: [Mayberry@TreasureDavis.com](mailto:Mayberry@TreasureDavis.com)  
 My Website: <https://www.treasuredavis.com/>

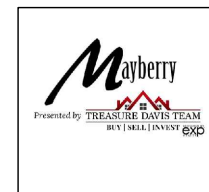

PRESENTED BY:  
**REALTY 360° VIEW**  
 Call or Text Us at: 720-770-1230  
 Email Direct at: [CR@Realty360View.com](mailto:CR@Realty360View.com)  
 Website: <https://realty360view.com/>  
 Address: 242 Linden St Fort Collins, CO 80524




SITE/LOCATION: **PLAN 1-XL - FARMHOUSE**

TITLE: **AS-BUILT DRAWING**

SCALE: NTS	DATE: 03/05/21	DRAWN: RGE	APPROVED: RGE
PROJECT NO: Prop.Tours/m1pxl	SHEET NO: 1/4	PHASE: 1	



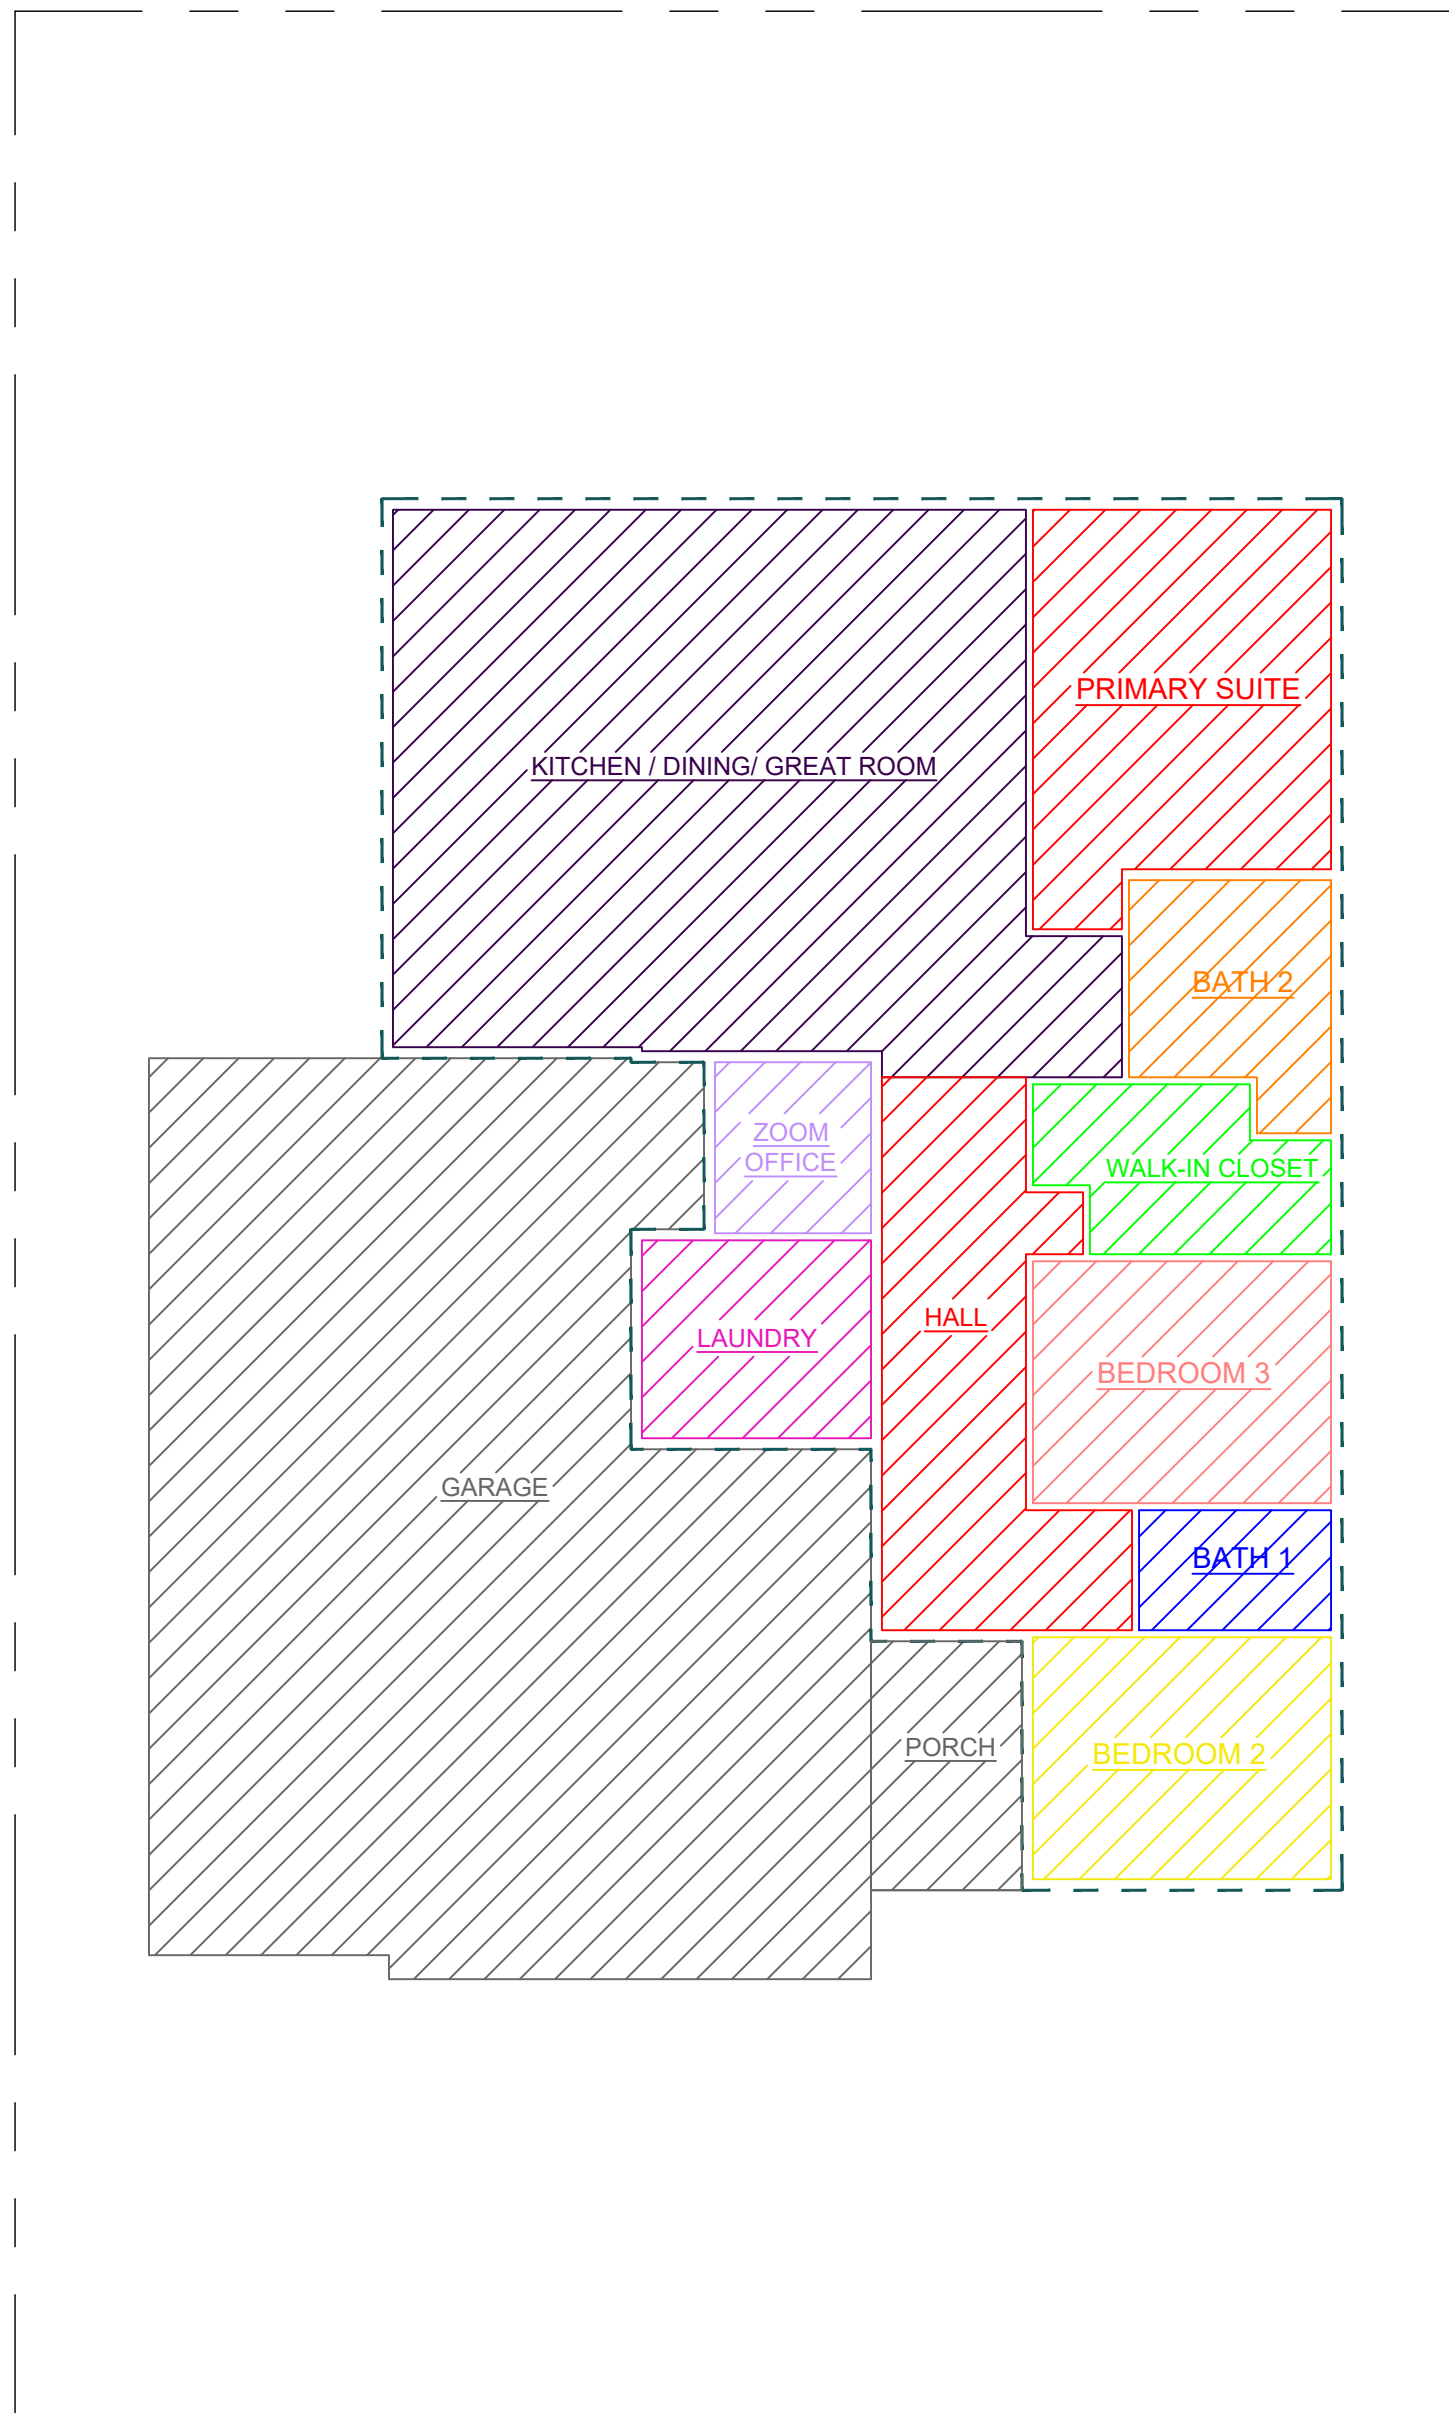

**1ST FLR. INTERNAL AREA**

BEDROOM 3	125sqft (ft <sup>2</sup> )
BEDROOM 2	125sqft (ft <sup>2</sup> )
PRIMARY SUITE	195sqft (ft <sup>2</sup> )
BATH 1	40sqft (ft <sup>2</sup> )
BATH 2	76sqft (ft <sup>2</sup> )
WALK-IN CLOSET	73sqft (ft <sup>2</sup> )
LAUNDRY	79sqft (ft <sup>2</sup> )
ZOOM OFFICE	46sqft (ft <sup>2</sup> )
KITCHEN/DINING/ GREAT ROOM	677sqft (ft <sup>2</sup> )
HALL	166sqft (ft <sup>2</sup> )
TOTAL INTERNAL AREA	1550sqft (ft <sup>2</sup> )

**1ST FLR. EXCLUDED AREA**

GARAGE	1003sqft (ft <sup>2</sup> )
PORCH	65sqft (ft <sup>2</sup> )
TOTAL EXCLUDED AREA	1068sqft (ft <sup>2</sup> )


**TOTAL FOOTPRINT**

1ST FLOOR FOOT PRINT	1689sqft (ft <sup>2</sup> )
----------------------	-----------------------------

**A**  
**2/4** 1ST FLOOR AREA CALCULATION  
SCALE: 1/8"=1'-0"

**Notes:**

1. ALL PLANS ARE CREATED BY REALTY 360° VIEW AND MADE EXCLUSIVELY FOR REAL ESTATE MARKETING PURPOSES.
2. SIZED AND DIMENSIONS ARE APPROXIMATE. ACTUAL MAY VARY.

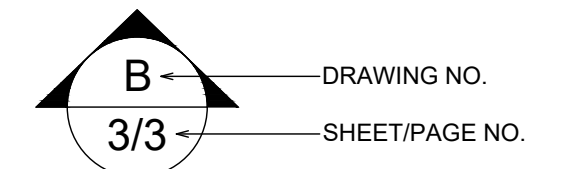

**WALL LEGEND**

EXISTING WALL

**ABBREVIATIONS**


T.O.P	TOP OF PARAPET
B.O.J	BOTTOM OF JOIST
B.O.D	BOTTOM OF DUCT
B.O.D	BOTTOM OF DUCT
F.F.L	FINISH FLOOR LINE
N.G.L	NATURAL GRADE LINE
CH	CEILING HEIGHT

1	ISSUED FOR INFORMATION	RGE	02/18/21
PHASE	DESCRIPTION:	BY:	DATE:

STATUS: **AS-BUILT**

REALTOR/BROKERAGE:

**TREASURE DAVIS TEAM**  
 Mobile: (719) 398-7190  
 Office:  
 Email: Mayberry@TreasureDavis.com  
 My Website: <https://www.treasuredavis.com/>

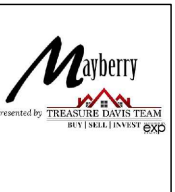

PRESENTED BY:

**REALTY 360° VIEW**  
 Call or Text Us at: 720-770-1230  
 Email Direct at: CR@Realty360View.com  
 Website: <https://realty360view.com/>  
 Address: 242 Linden St Fort Collins, CO 80524




SITE/LOCATION: **PLAN 1-XL - FARMHOUSE**

TITLE: **AS-BUILT DRAWING**


SCALE:	DATE:	DRAWN:	APPROVED:
1/8"=1'-0"	03/05/21	RGE	RGE
PROJECT NO:	SHEET NO:	PHASE:	
Prop.Tours/m1pxl	2/4	1	

Notes:

- 1. ALL PLANS ARE CREATED BY REALTY 360° VIEW AND MADE EXCLUSIVELY FOR REAL ESTATE MARKETING PURPOSES.
- 2. SIZED AND DIMENSIONS ARE APPROXIMATE. ACTUAL MAY VARY.

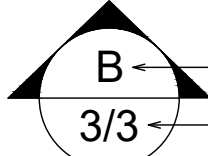
 DRAWING NO.  
 SHEET/PAGE NO.

**WALL LEGEND**

 EXISTING WALL

**ABBREVIATIONS**

T.O.P	TOP OF PARAPET
B.O.J	BOTTOM OF JOIST
B.O.D	BOTTOM OF DUCT
B.O.D	BOTTOM OF DUCT
F.F.L	FINISH FLOOR LINE
N.G.L	NATURAL GRADE LINE
CH	CEILING HEIGHT

1	ISSUED FOR INFORMATION	RGE	02/18/21
PHASE	DESCRIPTION:	BY:	DATE:

STATUS: **AS-BUILT**

REALTOR/BROKERAGE:

**TREASURE DAVIS TEAM**

Mobile: (719) 398-7190  
 Office:  
 Email: [Mayberry@TreasureDavis.com](mailto:Mayberry@TreasureDavis.com)  
 My Website: <https://www.treasuredavis.com/>



PRESENTED BY:

**REALTY 360° VIEW**

Call or Text Us at: 720-770-1230  
 Email Direct at: [CR@Realty360View.com](mailto:CR@Realty360View.com)  
 Website: <https://realty360view.com/>  
 Address: 242 Linden St Fort Collins, CO 80524




SITE/LOCATION:

PLAN 1-XL - FARMHOUSE

TITLE:

AS-BUILT DRAWING

SCALE: 1/8"=1'-0"	DATE: 03/05/21	DRAWN: RGE	APPROVED: RGE
PROJECT NO: Prop.Tours/m1pxl	SHEET NO: <b>3/4</b>	PHASE: <b>1</b>	

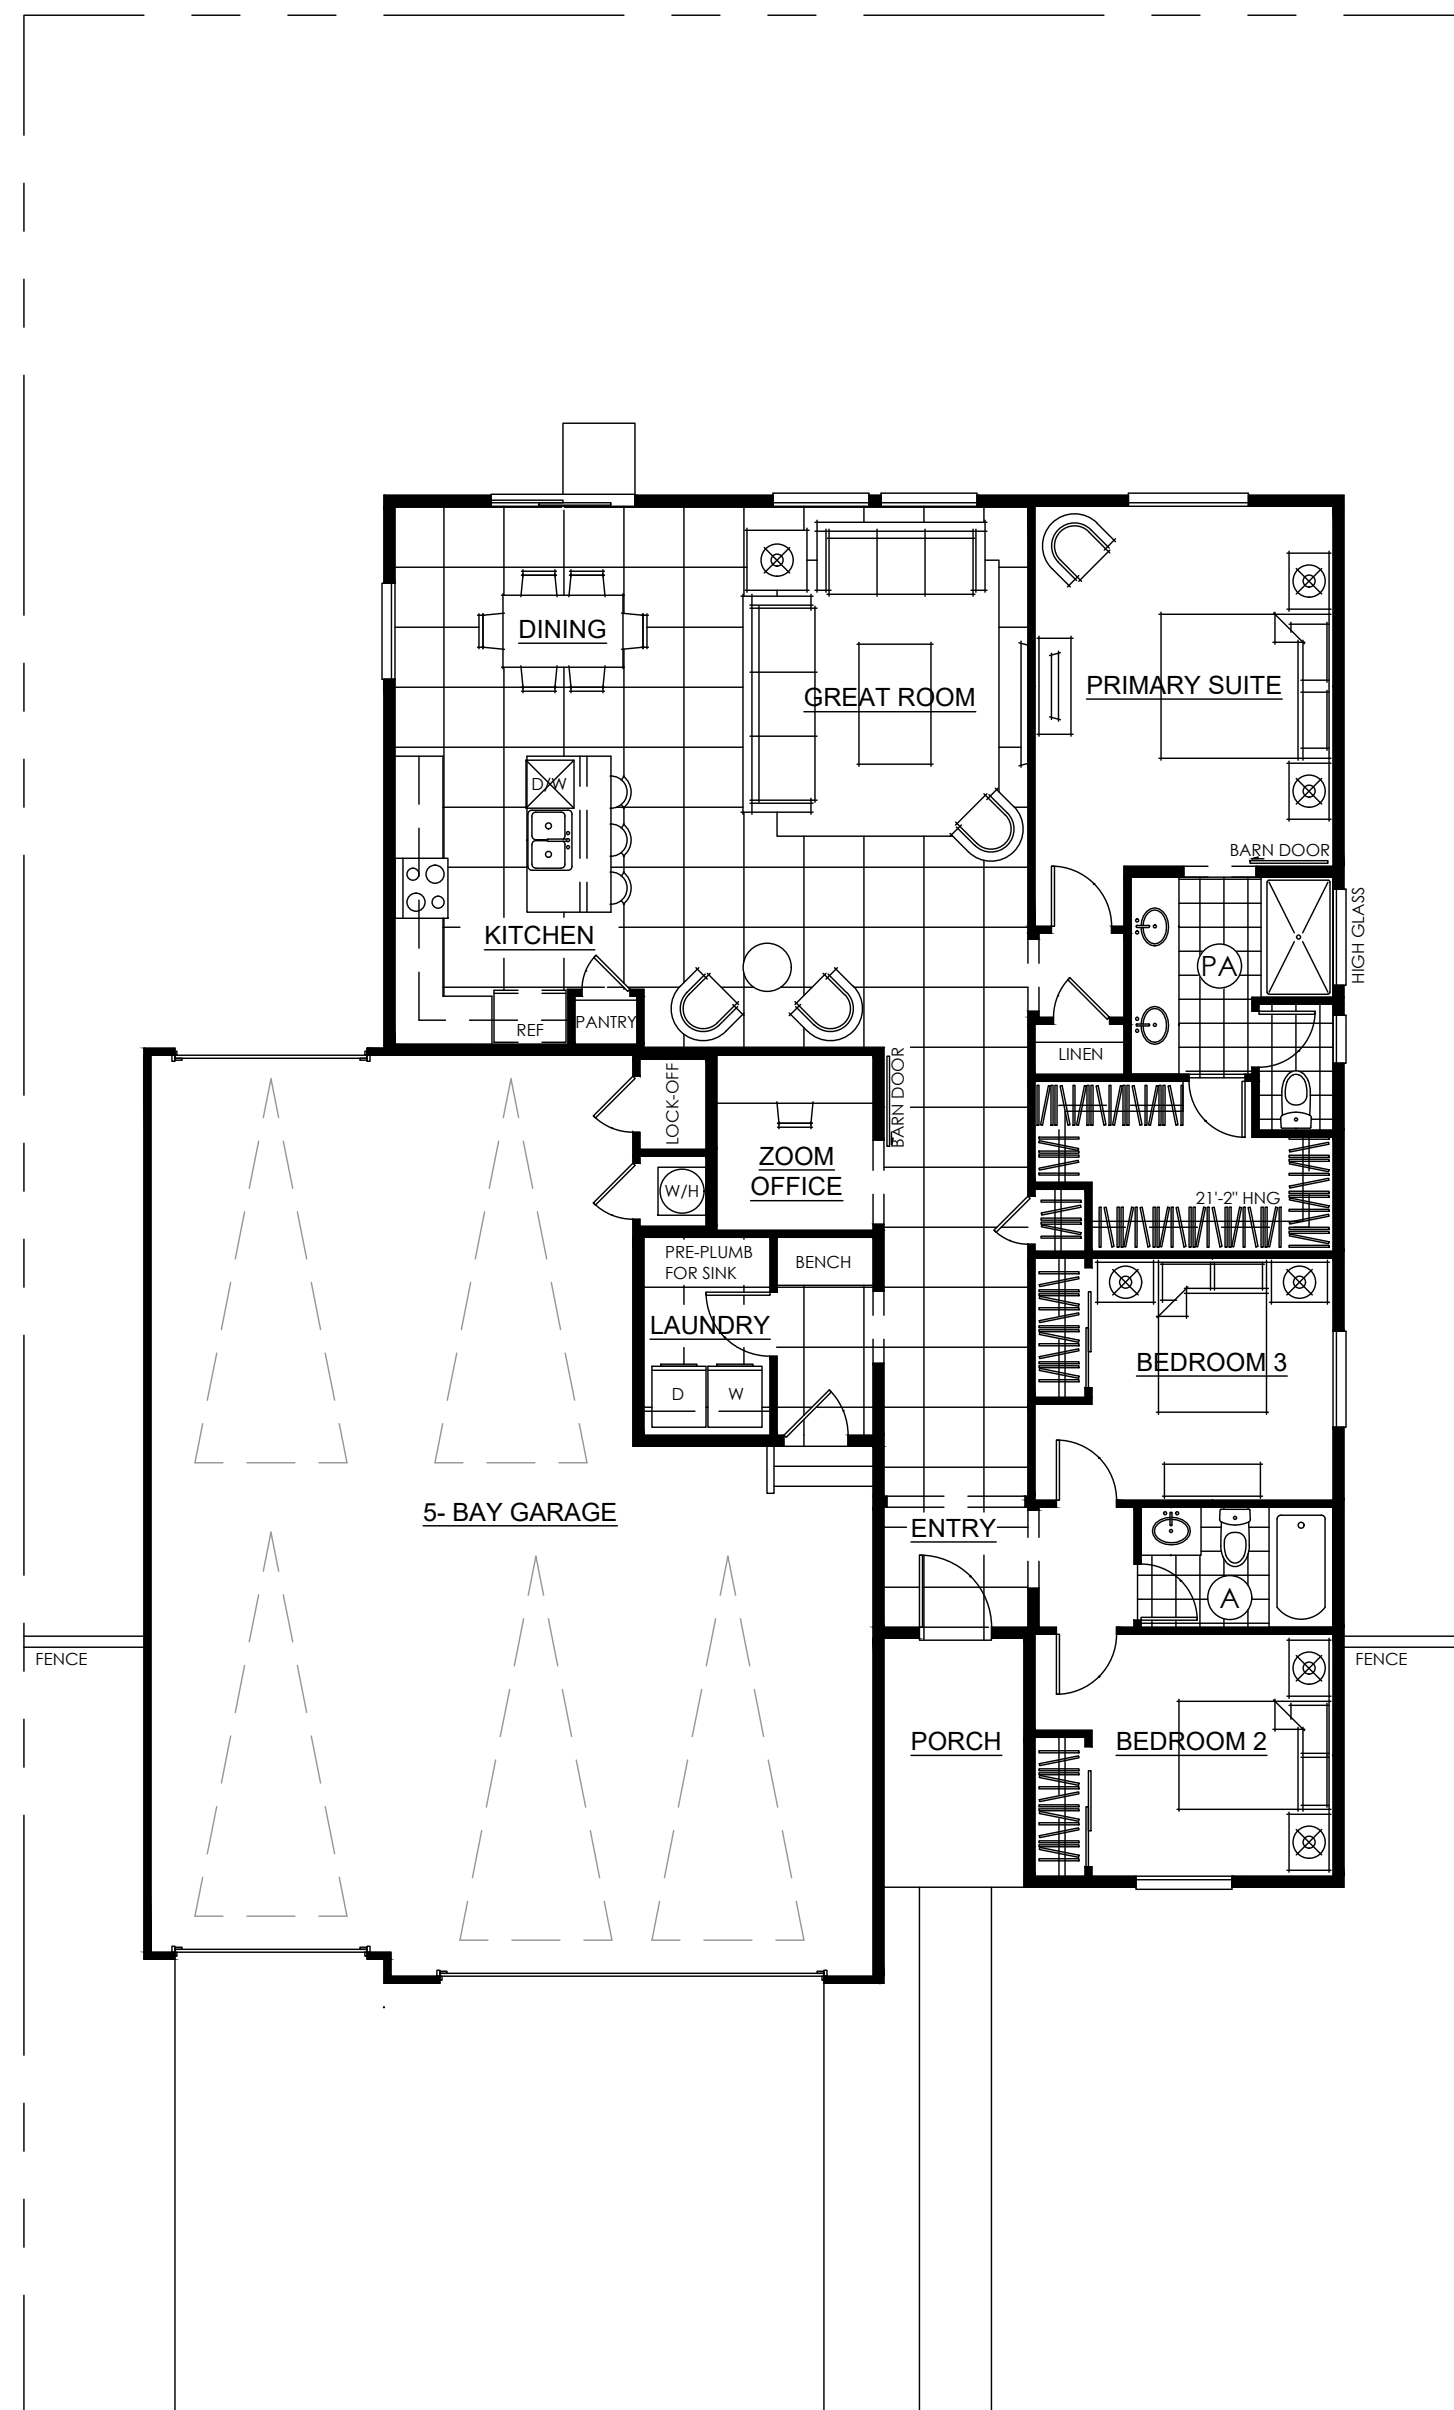

C  
4/4


D  
4/4

B  
4/4



**A**  
**3/4** FIRST FLOOR PLAN  
 SCALE: 1/8"=1'-0"

**Notes:**


- 1. ALL PLANS ARE CREATED BY REALTY 360° VIEW AND MADE EXCLUSIVELY FOR REAL ESTATE MARKETING PURPOSES.
- 2. SIZED AND DIMENSIONS ARE APPROXIMATE. ACTUAL MAY VARY.

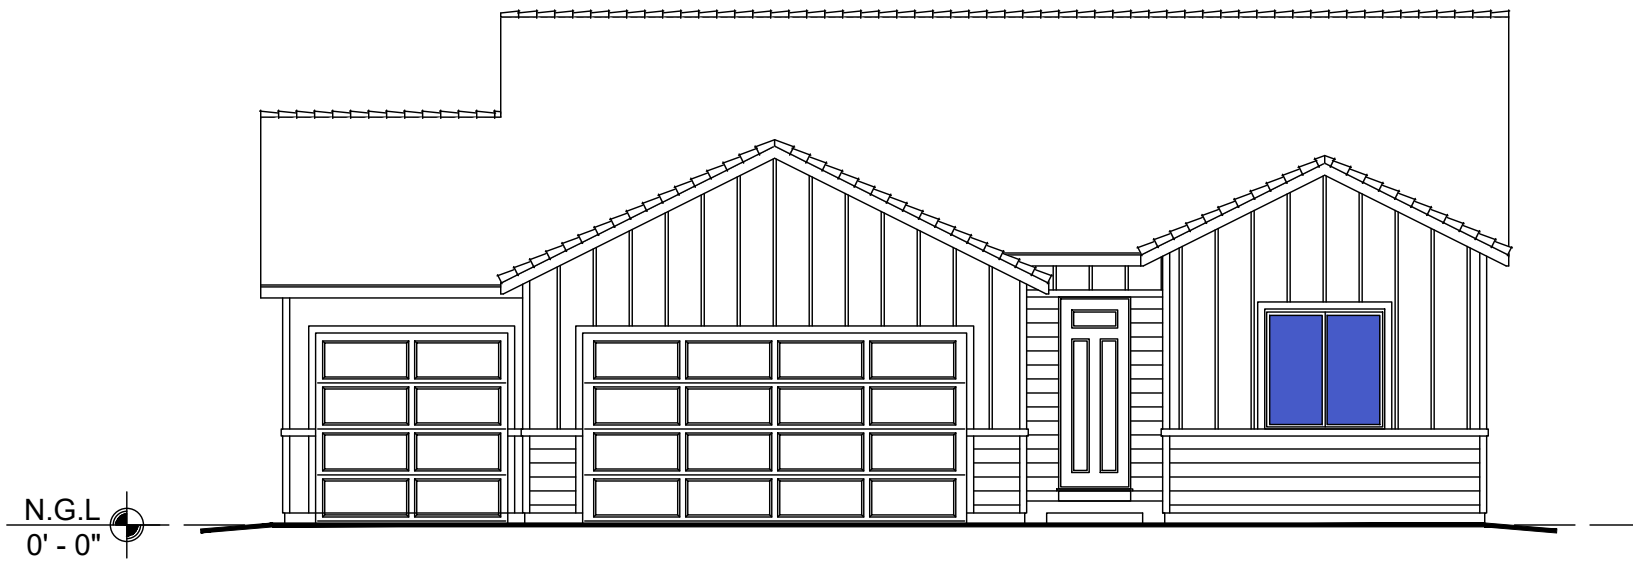


**A FRONT ELEVATION**  
4/4 SCALE: 1/8"=1'-0"

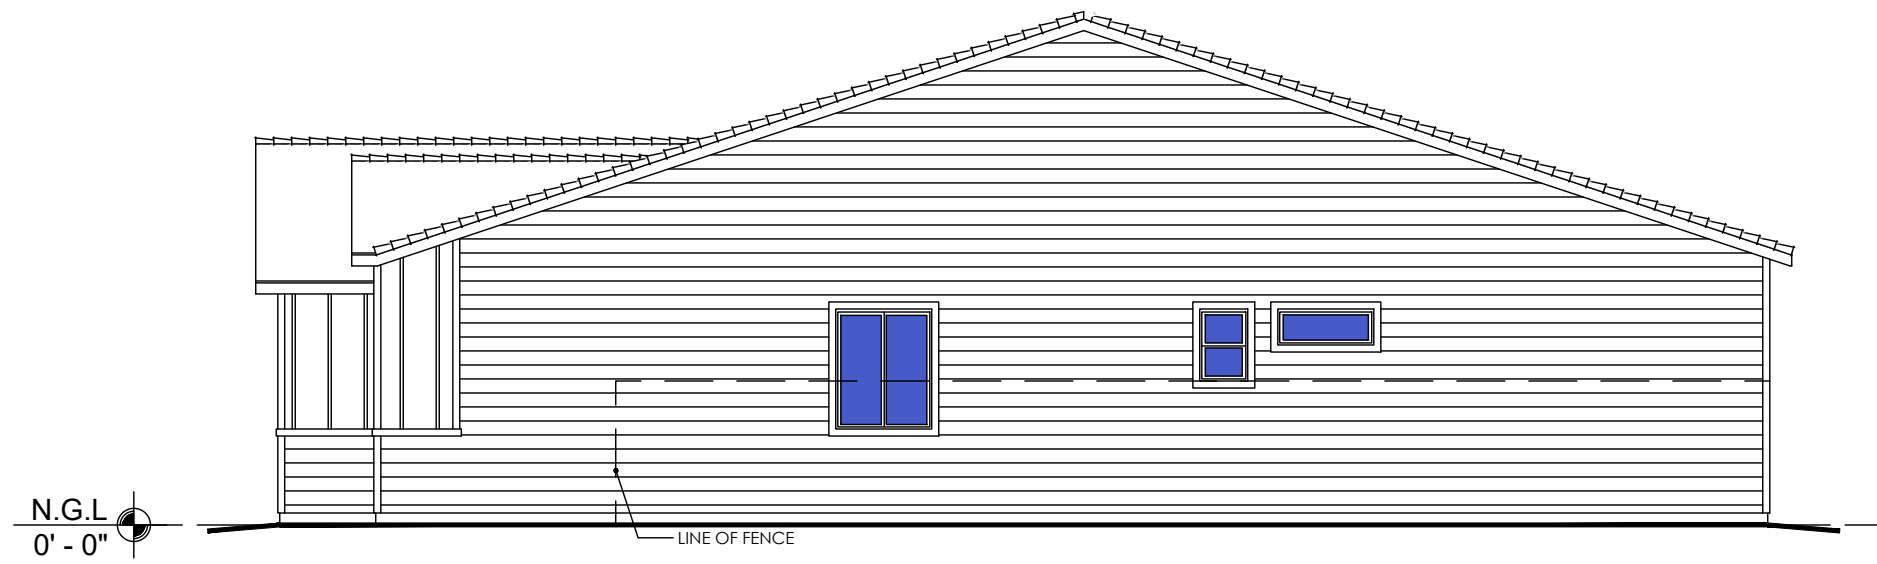

**B RIGHT ELEVATION**  
4/4 SCALE: 1/8"=1'-0"

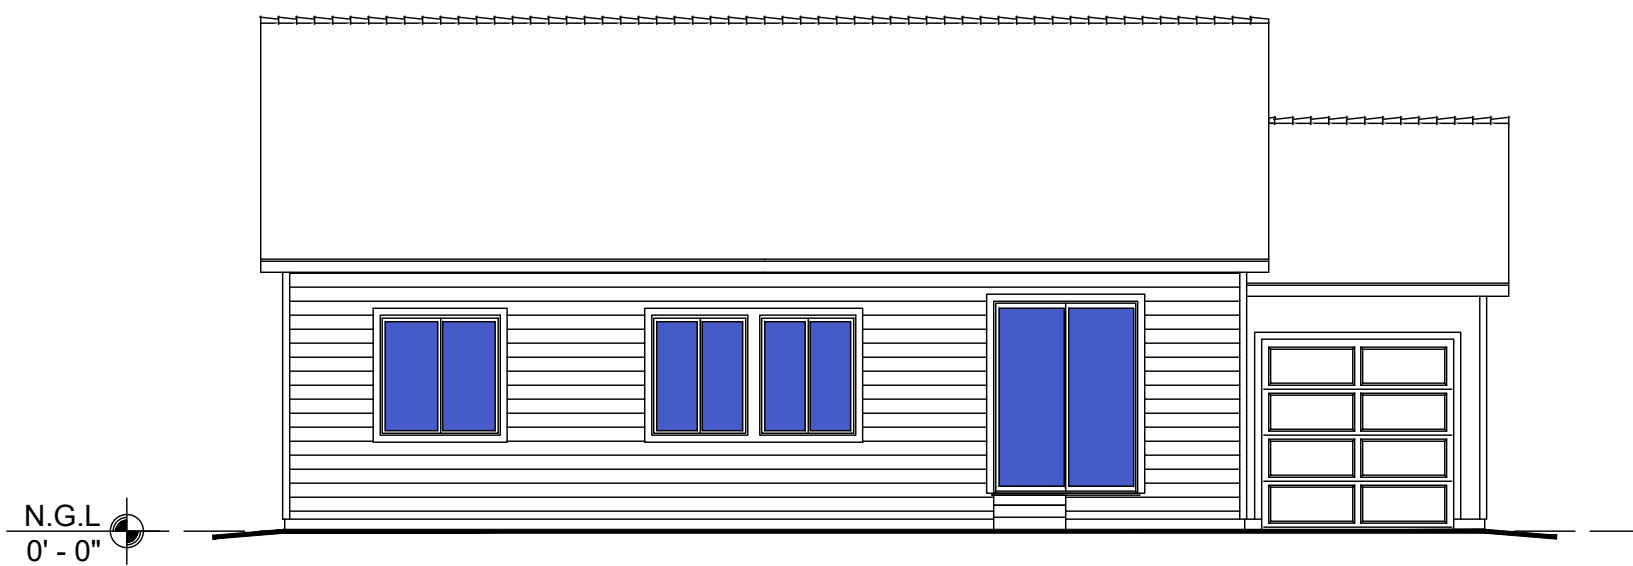

**C REAR ELEVATION**  
4/4 SCALE: 1/8"=1'-0"

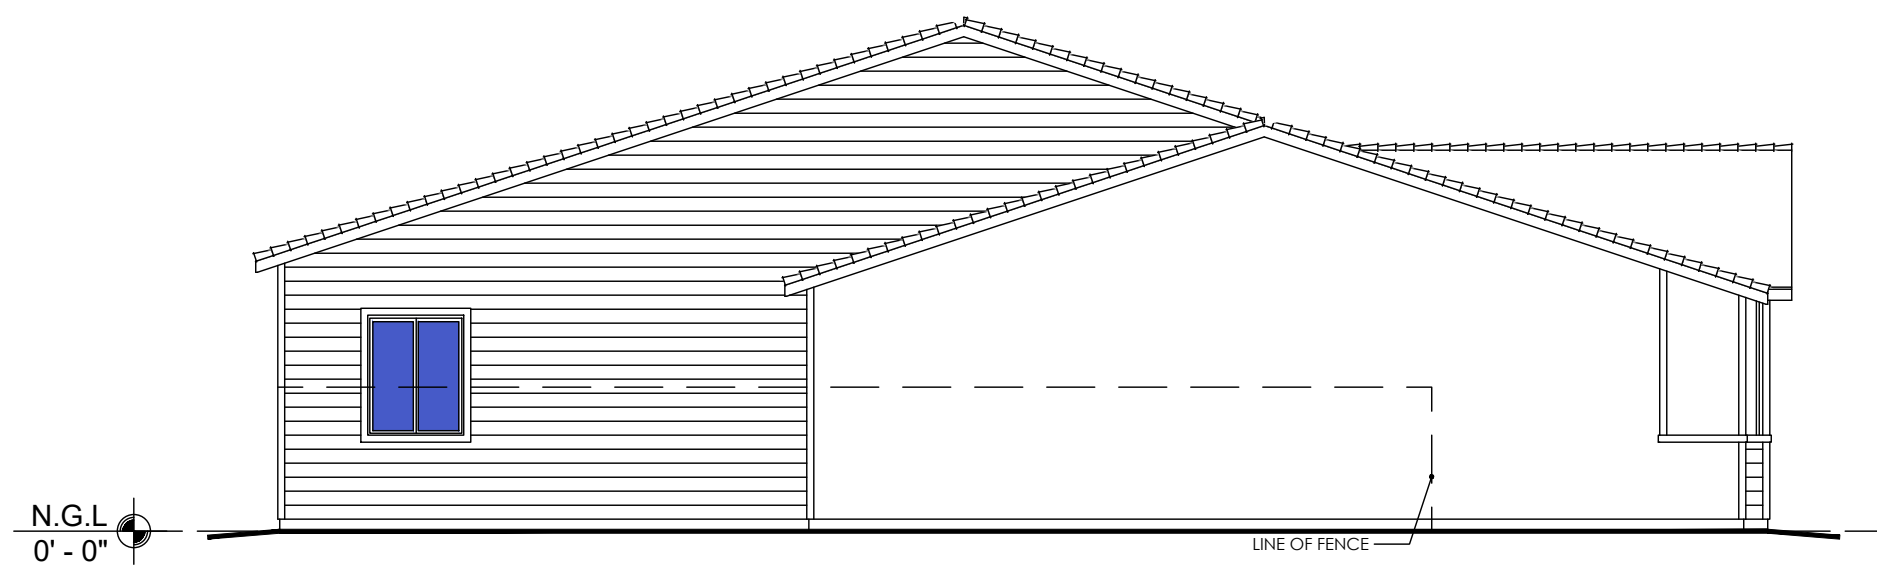

**D LEFT ELEVATION**  
4/4 SCALE: 1/8"=1'-0"

**WALL LEGEND**

	EXISTING WALL
--	---------------

**ABBREVIATIONS**

T.O.P	TOP OF PARAPET
B.O.J	BOTTOM OF JOIST
B.O.D	BOTTOM OF DUCT
B.O.D	BOTTOM OF DUCT
F.F.L	FINISH FLOOR LINE
N.G.L	NATURAL GRADE LINE
CH	CEILING HEIGHT

1	ISSUED FOR INFORMATION	RGE	02/18/21
PHASE	DESCRIPTION:	BY:	DATE:

STATUS: **AS-BUILT**

REALTOR/BROKERAGE:

**TREASURE DAVIS TEAM**

Mobile: (719) 398-7190

Office:

Email: [Mayberry@TreasureDavis.com](mailto:Mayberry@TreasureDavis.com)

My Website: <https://www.treasuredavis.com/>



PRESENTED BY:

**REALTY 360° VIEW**

Call or Text Us at: 720-770-1230

Email Direct at: [CR@Realty360View.com](mailto:CR@Realty360View.com)

Website: <https://realty360view.com/>

Address: 242 Linden St Fort Collins, CO 80524



SITE/LOCATION:

PLAN 1-XL - FARMHOUSE

TITLE:

AS-BUILT DRAWING

SCALE: 1/8"=1'-0"	DATE: 03/05/21	DRAWN: RGE	APPROVED: RGE
PROJECT NO: Prop.Tours/m1pxl	SHEET NO: 4/4	PHASE: 1	